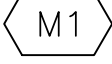
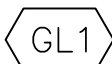
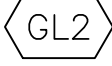
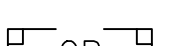
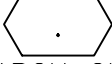
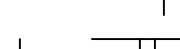
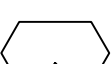
 
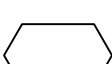
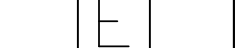


CIBC

100 FEDERAL STREET, FLOOR 30, BOSTON, MA, 02110

INTERIOR GLAZING

SG FOR FAB / INSTALLATION
2/20/26
FRAME: 1, 2, 7, 8


FRAMING SYSTEM(S) USED:	PERFORMANCE STANDARDS:	INFILL SCHEDULE		SYMBOLS		ABBREVIATIONS	
–ALL GLASS DOOR W/TOP & BOTTOM RAILS –MIRROR W/ ALUM GLAZING J CHANNEL –GALAXY BACKPAINTED GLASS	A. STRUCTURAL DESIGN IS BASED ON THE FOLLOWING LOADING CONDITIONS: –INTERIOR WIND LOAD: 5 PSF B. IF INCLUDED IN PROJECT CONTRACT, THEN STAMPED STRUCTURAL CALCULATIONS SHALL BE SUBMITTED ONLY AFTER DRAWINGS HAVE BEEN RETURNED EITHER STAMPED "APPROVED" OR "APPROVED AS NOTED"	MARK	INFILL DESCRIPTION		CENTER LINE	AFF	ABOVE FINISH FLOOR
			¼" POLISH PLATE GLASS MIRRORS		ELEVATION MARK	ALUM	ALUMINUM
			¼" BACKPAINTED ANNEALED GALAXY GLASS 1–4 14755G W/ SAFETY BACK		WORK POINT (SUBSTRUCTURE)	ARCH	ARCHITECT
					WORK POINT (PANEL)	BO	BOTTOM OF
					JAMB	BOSTL	BOTTOM OF STEEL
					OUTSIDE 90 DEGREE CORNERS	CJ	CAULK JOINT
			½" CLEAR TEMPERED GLASS		INSIDE 90 DEGREE CORNERS	CONT	CONTINUOUS
					90 DEGREE 'T' @ JAMB	DTL	DETAIL
					90 DEGREE 'T' INTERSECTION	DF	DOOR FRAME
					OUTSIDE ACUTE CORNERS	DFO	DOOR FRAME OPENING
					INSIDE ACUTE CORNERS	DL	DEAD LOAD
					OUTSIDE OBTUSE CORNERS	DLO	DAYLIGHT OPENING
					INSIDE OBTUSE CORNERS	DLR	DEAD LOAD REACTION
					REVISION MARK W/ NUMBER	DO	DOOR OPENING
					DETAIL NUMBER } SHEET NUMBER }DETAIL CALLOUT	EO	EDGE OF
					EXPANSION MULLION	FMD	FORMED
					MEDIUM OR HEAVY WEIGHT MULLION	FO	FACE OF
					SPLICE JOINT LOCATION	FOG	FACE OF GLASS
					INFILL TYPE	FS	FRAME SIZE
					FASTENER TYPE	GB	GLASS BITE
					DOOR NUMBER	GC	GENERAL CONTRACTOR
					DEAD LOAD ANCHOR	GS	GLASS SIZE
					WIND LOAD ANCHOR	HORZ	HORIZONTAL
					WINDLOAD ANCHOR (ELEVATION)	HP	HIGH POINT
					DEADLOAD ANCHOR (ELEVATION)	LP	LOW POINT
					GRAIN DIRECTION (VERTICAL)	MF	MIRROR FACE
					GRAIN DIRECTION (HORIZONTAL)	ML	MULLION LENGTH
					PANEL TAG	MO	MASONRY OPENING
						MS	MEDIUM STYLE
						MULL	MULLION
						N/A	NOT APPLICABLE
						NBSGC	NOT BY SALEM GLASS COMPANY
						NIC	NOT IN CONTRACT
						NOM	NOMINAL
						NTS	NOT TO SCALE
						OPP	OPPOSITE HAND
						PF	PANEL FACE
						PS	PANEL SIZE
						PSD	PANEL SYSTEM DEPTH
						REF	REFERENCE
						REQ'D	REQUIRED
						RO	ROUGH OPENING
						SFS	SILL FLASHING SIZE
						SGC	SALEM GLASS COMPANY
						SIM	SIMILAR
						SPD	SPANDREL
						SS	STAINLESS STEEL
						STL	STEEL
						TBD	TO BE DETERMINED
						THK	THICK
						TOS	TOP OF SLAB
						TOSTL	TOP OF STEEL
						TYP	TYPICAL
						UNO	UNLESS NOTED OTHERWISE
						VIF	VERIFY IN FIELD
						VIS	VISION
						WL	WIND LOAD
						WLR	WIND LOAD REACTION
						WP	WORK POINT
GENERAL NOTES:		DOOR SWING DIAGRAM		TABLE OF CONTENTS			
1. STRUCTURAL STEEL AND CONCRETE DIMENSIONS ARE DERIVED FROM THE CONTRACT DRAWINGS AND ARE THE RESPONSIBILITY OF THE GENERAL CONTRACTOR. 2. FIELD DIMENSIONS AND/OR MEASUREMENTS ARE EXCLUDED FROM THIS WORK UNLESS SPECIFICALLY STATED OTHERWISE. 3. SALEM GLASS COMPANY WILL NOT ASSUME THE RESPONSIBILITY OF COORDINATION BETWEEN SALEM GLASS COMPANY'S DRAWINGS AND OTHER TRADE'S DRAWINGS. 4. ALL BUILDING ELEMENTS USED TO SUPPORT THE GLAZING SYSTEM ARE TO BE STRUCTURALLY SOUND AND PROVIDE ADEQUATE SUPPORT TO WITHSTAND LOADS IMPOSED BY THE GLAZING SYSTEM. 5. THE GLAZING SYSTEM HAS BEEN DESIGNED TO INCORPORATE, WITHOUT FAILURE OF MATERIALS OR PERMANENT DEFORMATION, A MAXIMUM LIVE LOAD DEFLECTION OF +/- 1/4". 6. ATTACHMENT OF ALL MATERIALS TO THE GLAZING SYSTEM IS STRICTLY PROHIBITED UNLESS SPECIFICALLY SHOWN ON APPROVED SHOP DRAWINGS. 7. ALL DISSIMILAR MATERIALS IN CONTACT WITH ALUMINUM MEMBERS ARE TO BE ISOLATED FROM THE ALUMINUM USING BITUMINOUS PAINT. 8. THESE DRAWINGS AND THE INFORMATION CONTAINED HEREIN ARE THE SOLE EXPRESSED PROPERTY OF SALEM GLASS COMPANY. USE OF THESE DRAWINGS WITHOUT THE PERMISSION OF SALEM GLASS COMPANY SHALL BE CAUSE FOR LEGAL RECOURSE BY SALEM GLASS COMPANY. 9. REQUESTS FOR INFORMATION (RFI'S) DELAYED OR NOT ANSWERED COULD AFFECT THE START OF FABRICATION. IN THIS CASE, PROMISED DELIVERY DATES CANNOT BE GUARANTEED. 10. THESE DRAWINGS ARE BASED UPON SALEM GLASS COMPANY'S INTERPRETATION OF THE CONTRACT DOCUMENTS. DUE DILIGENCE HAS BEEN MADE TO ELIMINATE ALL ERRORS. HOWEVER, SINCE THE POSSIBILITY OF ERRORS EXISTS, SALEM GLASS COMPANY ASSUMES ONLY THE RESPONSIBILITY OF MANUFACTURING THE GLAZING SYSTEM IN ACCORDANCE WITH APPROVED SHOP DRAWINGS. 11. APPROVAL OF THESE DRAWINGS BY THE ARCHITECT SHALL CONSTITUTE ACCEPTANCE OF ALL DEVIATIONS SHOWN HEREIN. 12. SALEM GLASS COMPANY IS NOT RESPONSIBLE FOR ERRORS RESULTING FROM THE USE OF THESE DRAWINGS BY OTHER TRADES. 13. TO MAINTAIN SCHEDULE, FIRST SUBMISSION OF SHOP DRAWINGS MIGHT ONLY INCLUDE A PRELIMINARY STRUCTURAL ANALYSIS. FOR THIS REASON, SALEM GLASS COMPANY RESERVES THE RIGHT TO CHANGE FASTENER SIZES, WALL THICKNESS, ANCHOR SIZE, ETC., UPON FORMALIZING THE STRUCTURAL ANALYSIS AND TO IMPROVE THE PERFORMANCE OF THE GLAZING SYSTEM. THESE CHANGES WILL BE INTERNAL CHANGES TO THE SYSTEM AND WILL NOT VISUALLY AFFECT THE SYSTEM. IF VISUAL CHANGES ARE REQUIRED, THE ARCHITECT AND GENERAL CONTRACTOR WILL BE NOTIFIED. 14. SALEM GLASS WILL ONLY INSTALL ITS MATERIALS BASED ON BUILDING CONTROL BENCHMARKS PROVIDED BY THE GENERAL CONTRACTOR. SALEM GLASS WILL NOT INSTALL ITS MATERIALS BASED ON OTHER SUBCONTRACTOR'S LAYOUTS OR INSTALLED WORK.		SUBMISSION		DATE	STATUS	REVISION	DESCRIPTION/SHEETS
		01	11/14/25	FOR APPROVAL	00	C101–C102, P101, E101–E103, H101–H102, V101–V102	
		IN HOUSE	2/20/26	FAB/INSTALL		C101–C102, P101, E101–E103, H101–H102, V101–V102	
		–	mm/dd/yy	–			
		–	mm/dd/yy	–			
PROJECT	CIBC	ARCHITECT	INTERIOR ARCHITECTS	GENERAL CONTRACTOR	STRUCTURE TONE
DESCRIPTION	REVISED PER FAB/INSTALL & VIF	BY	SM		
DATE	02/06/26				
REV	01				
PROJ NO	8859				
DATE	11/14/25				
DRAWN	SM				
CHECKED	SB/MO				
FILE NAME	8859 c 1				
SCALE	NO SCALE				
SHEET NUMBER	C101				

INTERIOR GLAZING FASTENER INDEX

FASTENER#:	1	IMAGE: 
PART#:		
FASTENAL #0138869		
DESCRIPTION: #6-20 X 1-1/2" PFH TYPE-AB SMS *ZINC		

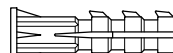FASTENER#:	2	IMAGE: 	*SGC INVENTORY*
PART#:			
FASTENAL #50985			
DESCRIPTION: #6/#8 TOOTHED INSERT *PLASTIC			


FASTENER#:	3	IMAGE: 
PART#:		
FASTENAL #1173058		
DESCRIPTION:		#12-11 X 2" PFH TYPE-A SMS *18-8SS

FASTENER#:	4	IMAGE: 
PART#:		
FASTENAL #1173036		
DESCRIPTION: #10-12 x 1-1/2" PFH TYPE-A SMS *18-8SS		

FASTENER#:	5	IMAGE: 	*SGC INVENTORY*
PART#:			
FASTENAL #50985			
DESCRIPTION: #10/#12 GREEN MASONRY PLUG SMS *PLASTIC			



PROJECT	CIBC	PROJ NO	8859
ARCHITECT	INTERIOR ARCHITECTS	DATE	11/14/25
GENERAL CONTRACTOR	STRUCTURE TONE	DRAWN	SM
		CHECKED	SB/MO
		FILE NAME	8859 c 1
		SCALE	NO SCALE
		SHEET NUMBER	C102

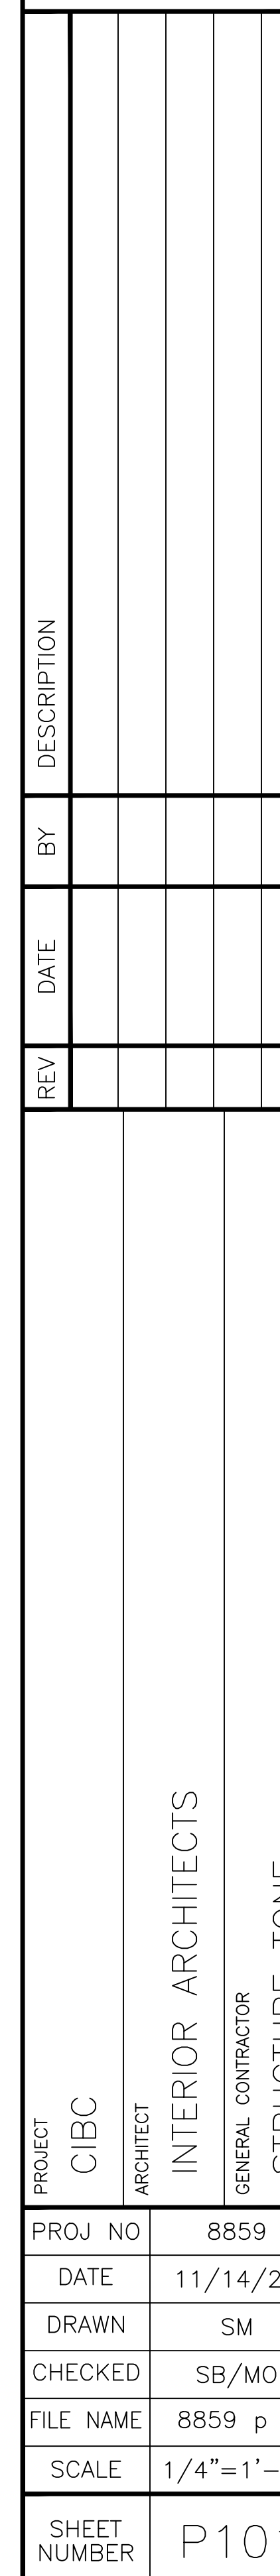

PROJECT	CIBC						
ARCHITECT	INTERIOR ARCHITECTS						
GENERAL CONTRACTOR	STRUCTURE TONE						
PROJ NO	8859						
DATE	11/14/25						
DRAWN	SM						
CHECKED	SB/MO						
TITLE NAME	8859 e 1						
SCALE	1/2"=1'-0"						
SHEET NUMBER	E101						
REV	01	DATE	02/06/26	BY	SM	DESCRIPTION	REVISED PER FAB/INSTALL & VIF





ALL DIMENSIONS TO BE
VERIFIED IN FIELD BY SGC
PRIOR TO FABRICATION

- M1


1/4" POLISH PLATE GLASS MIRRORS
- GL1

1/4" BACKPAINTED GALAXY ANNEALED GLASS -088000.03-GALAXY GLASS 1-4 14755G
- GL2

1/2" CLEAR TEMPERED GLASS

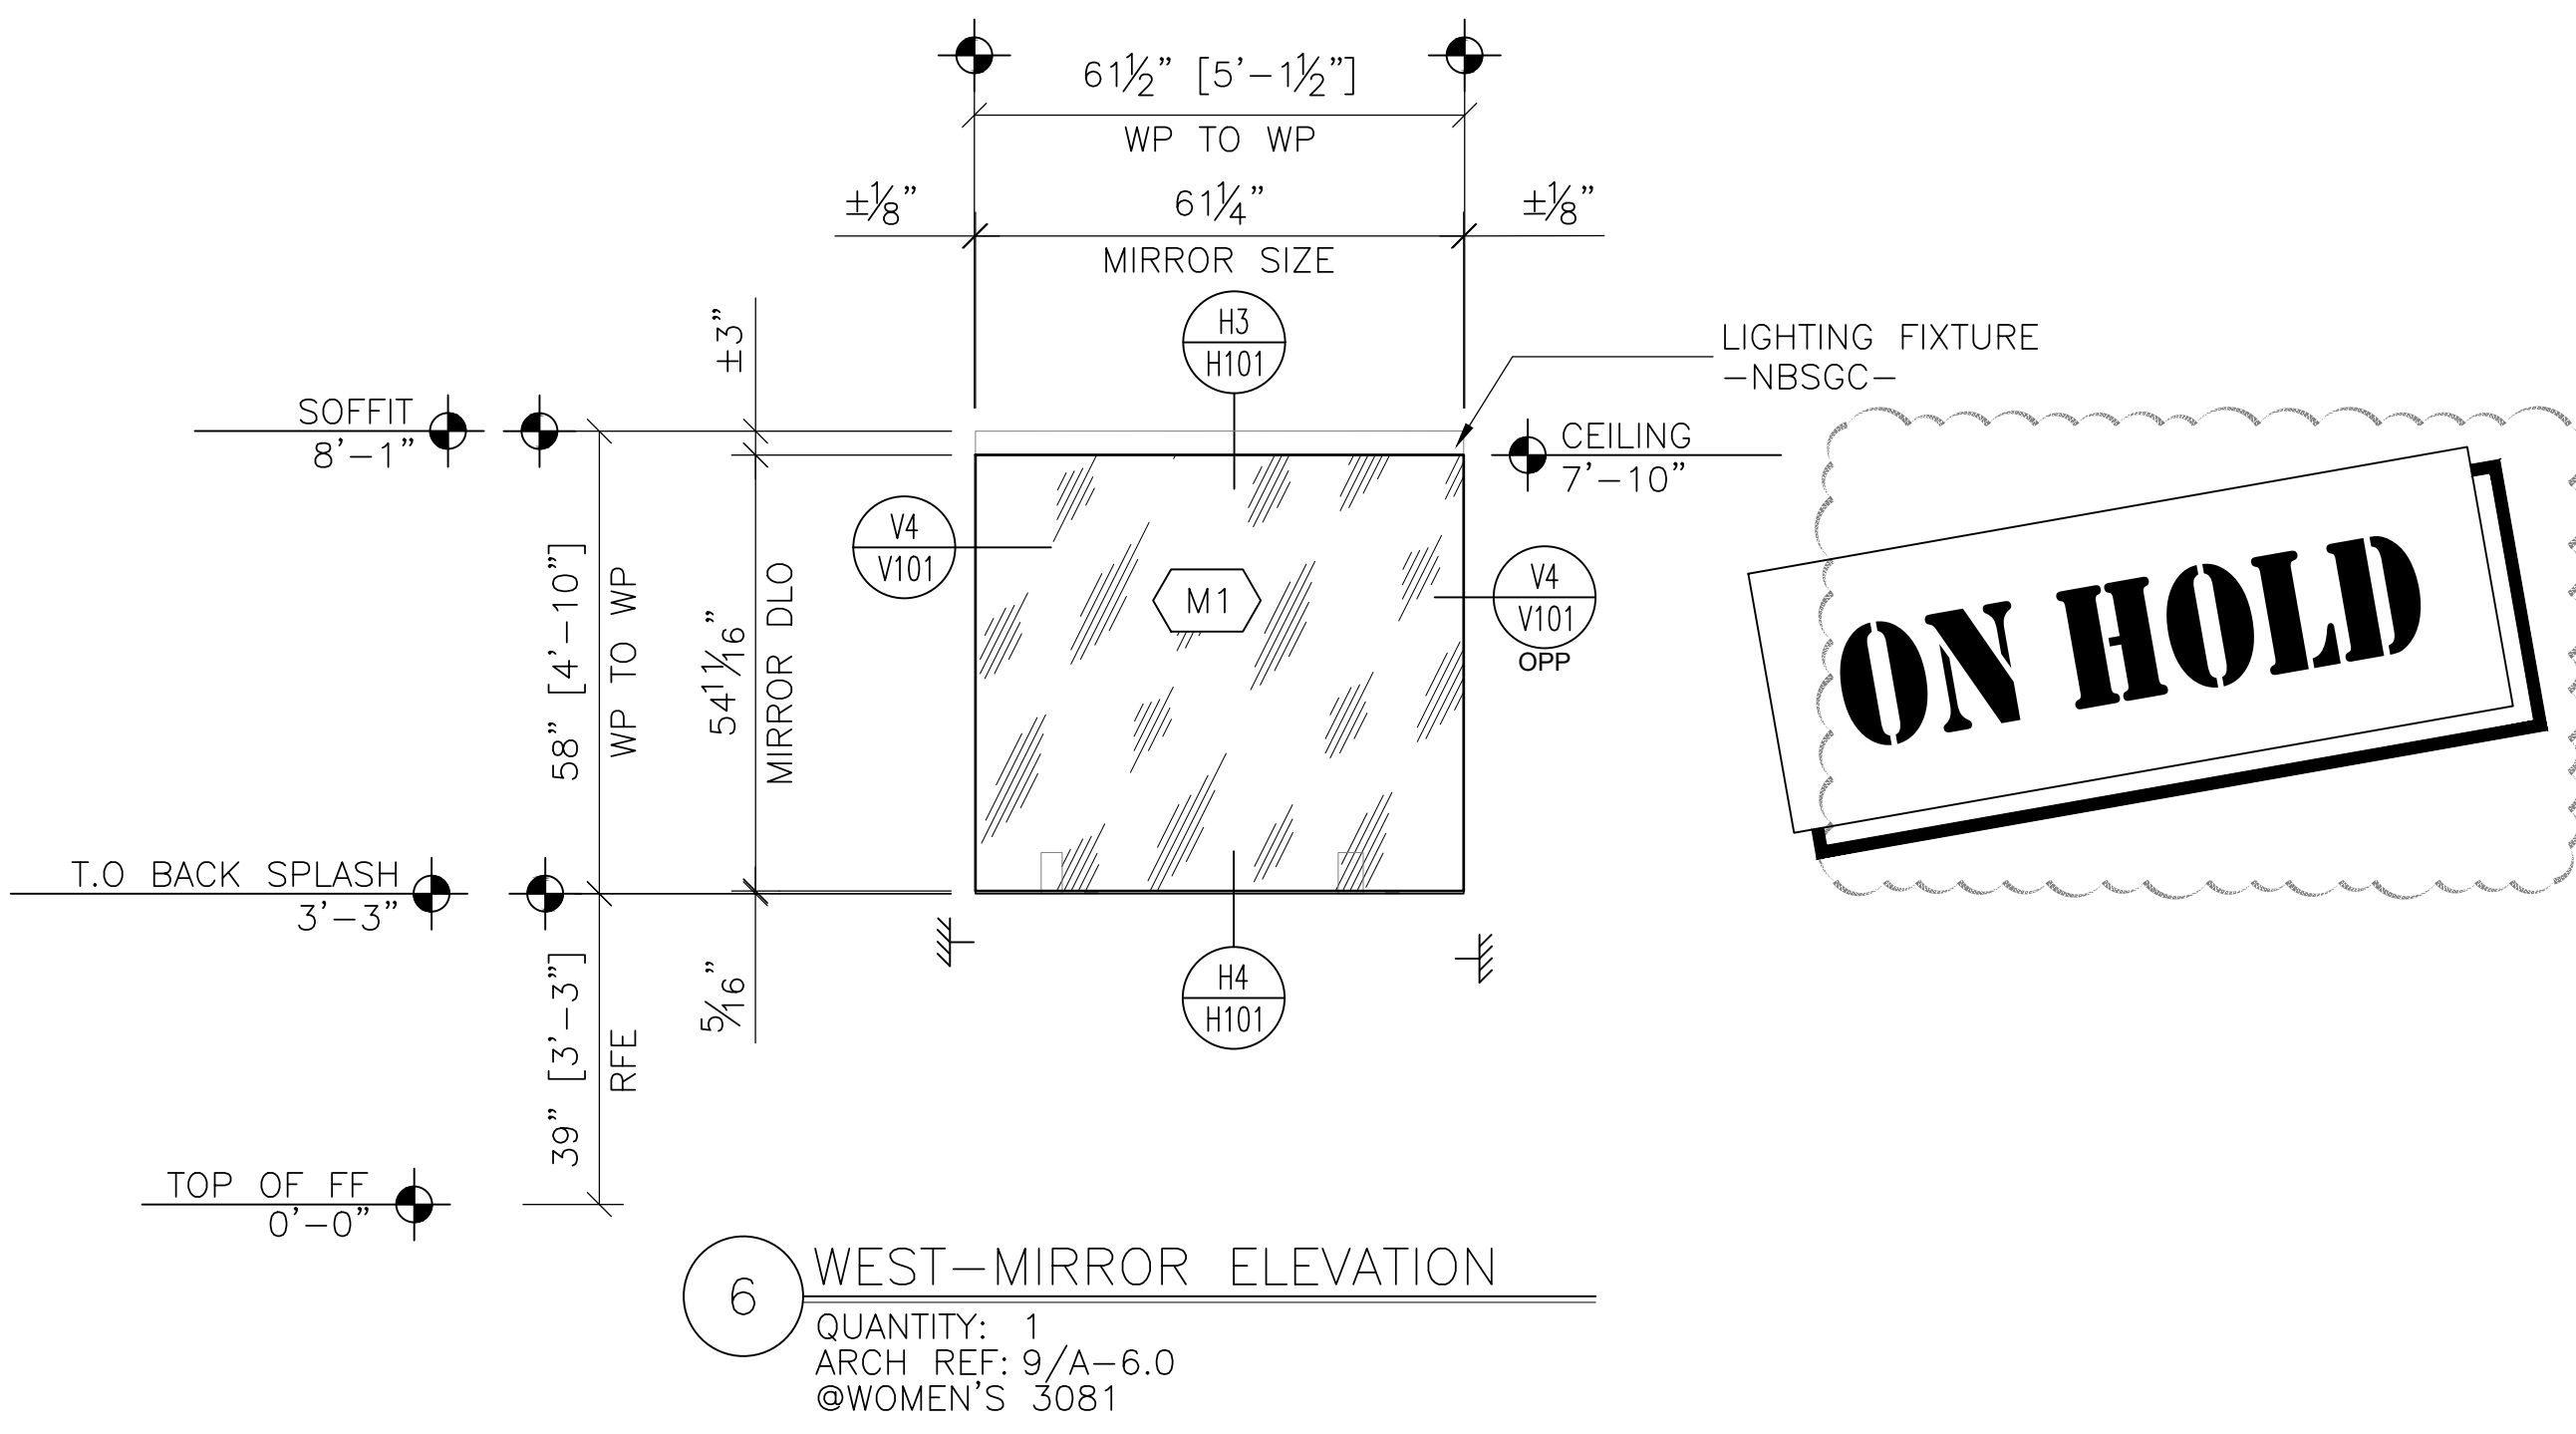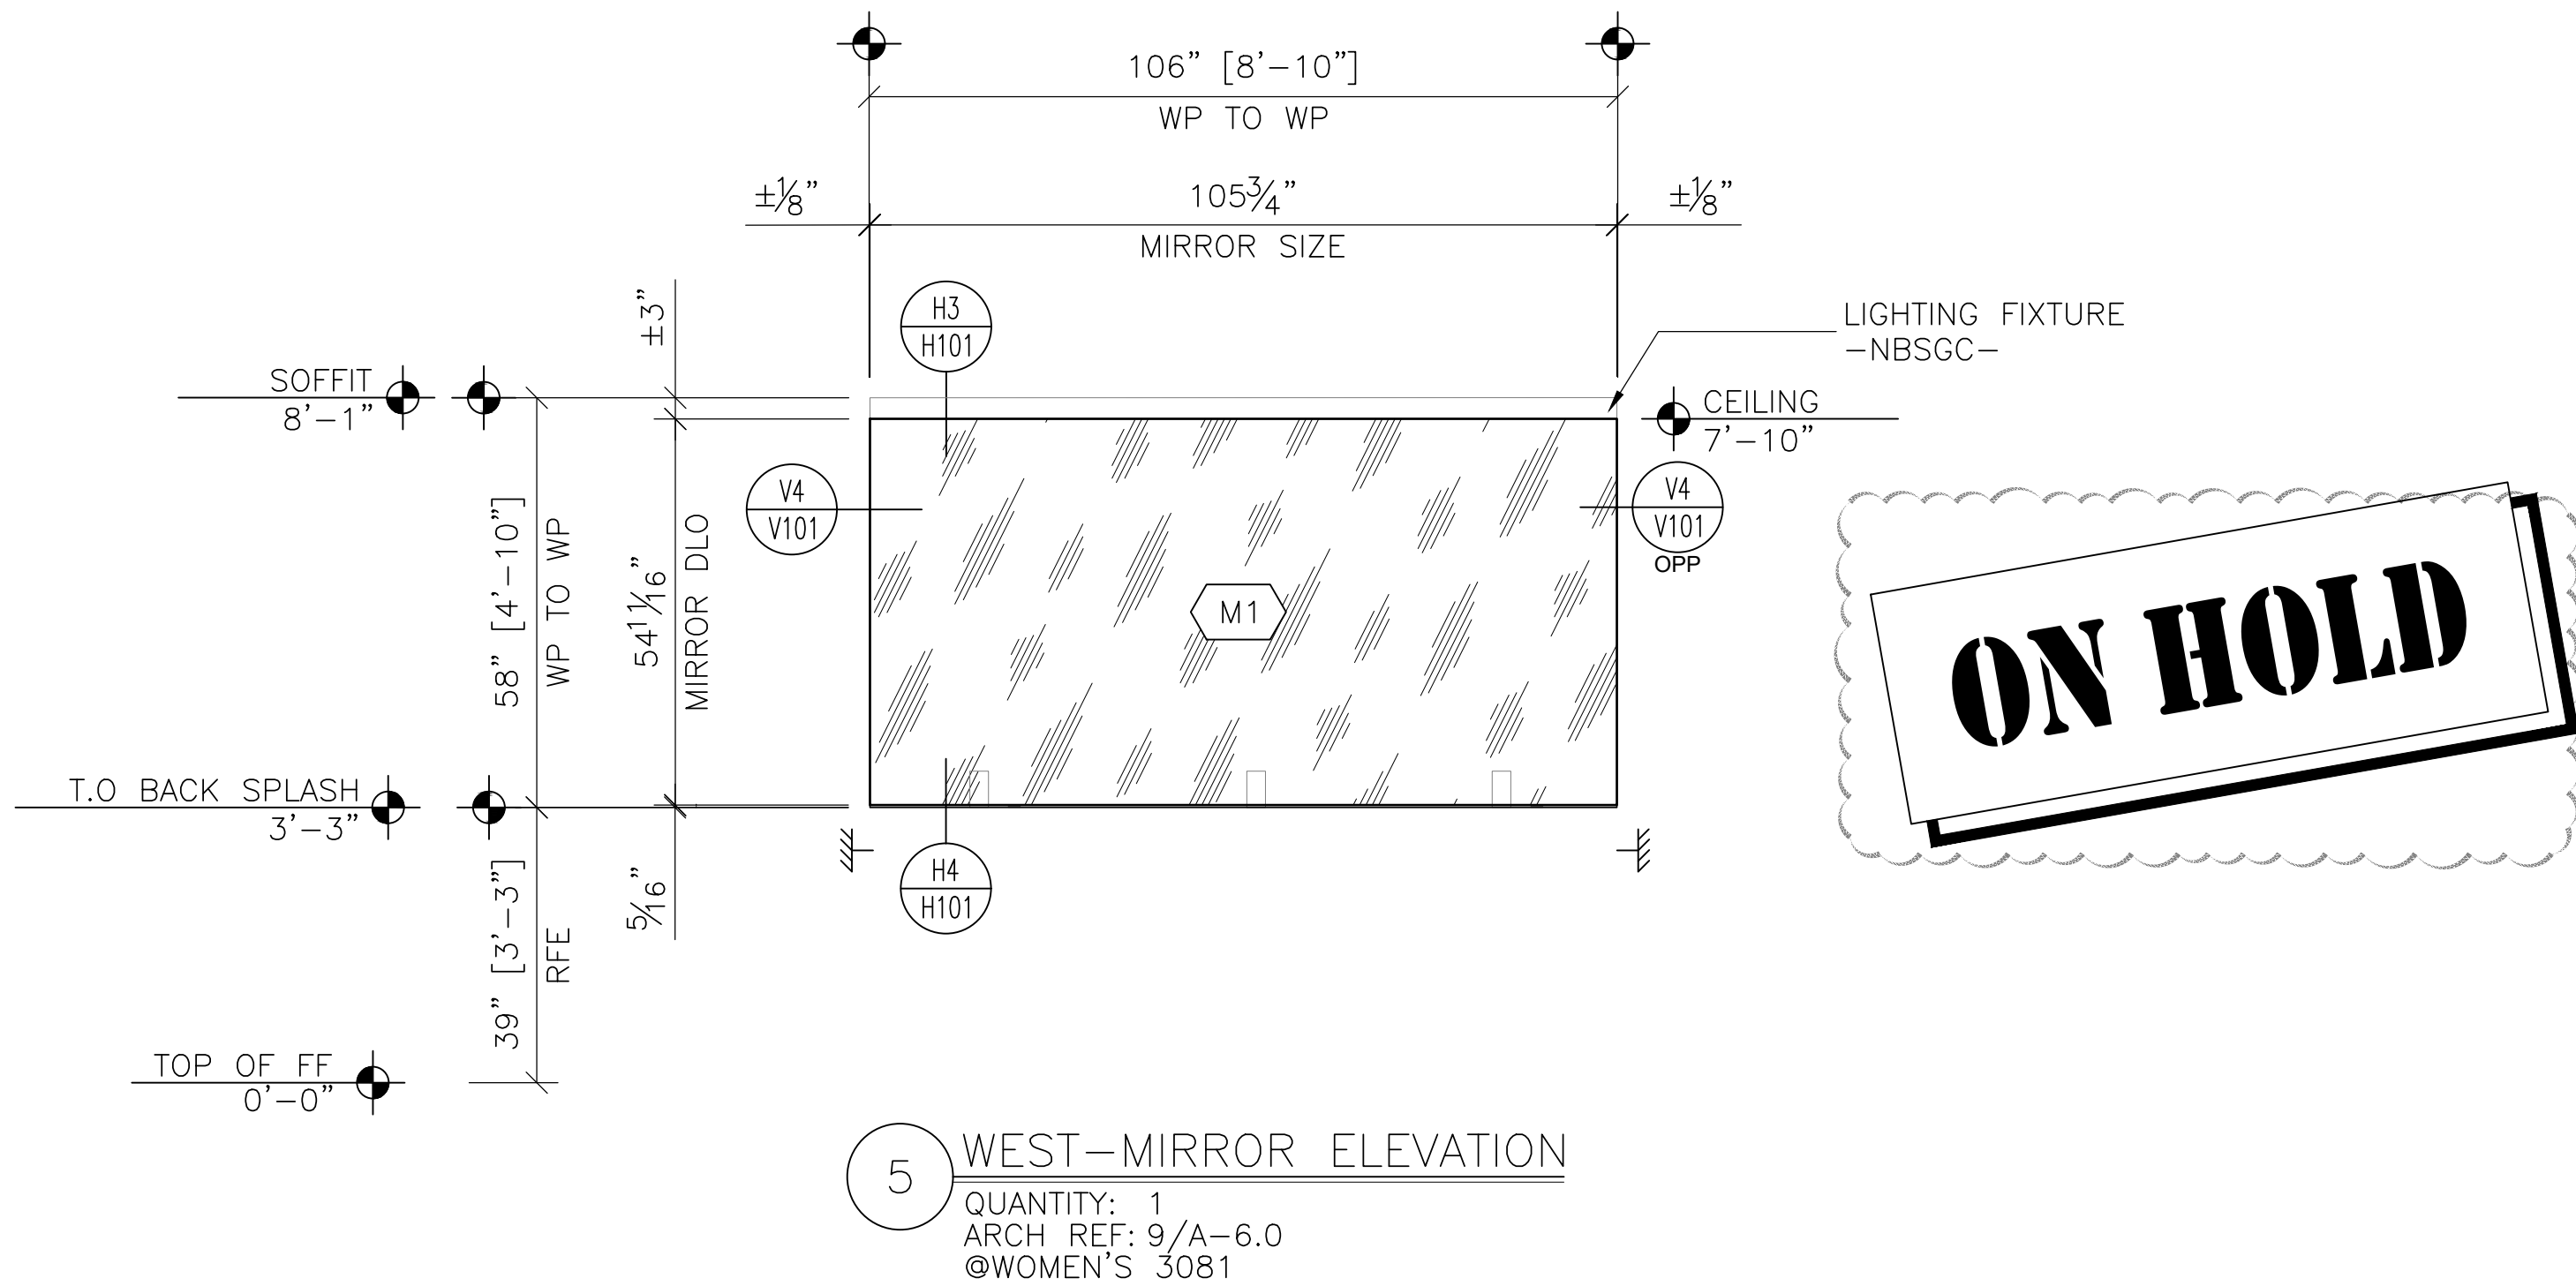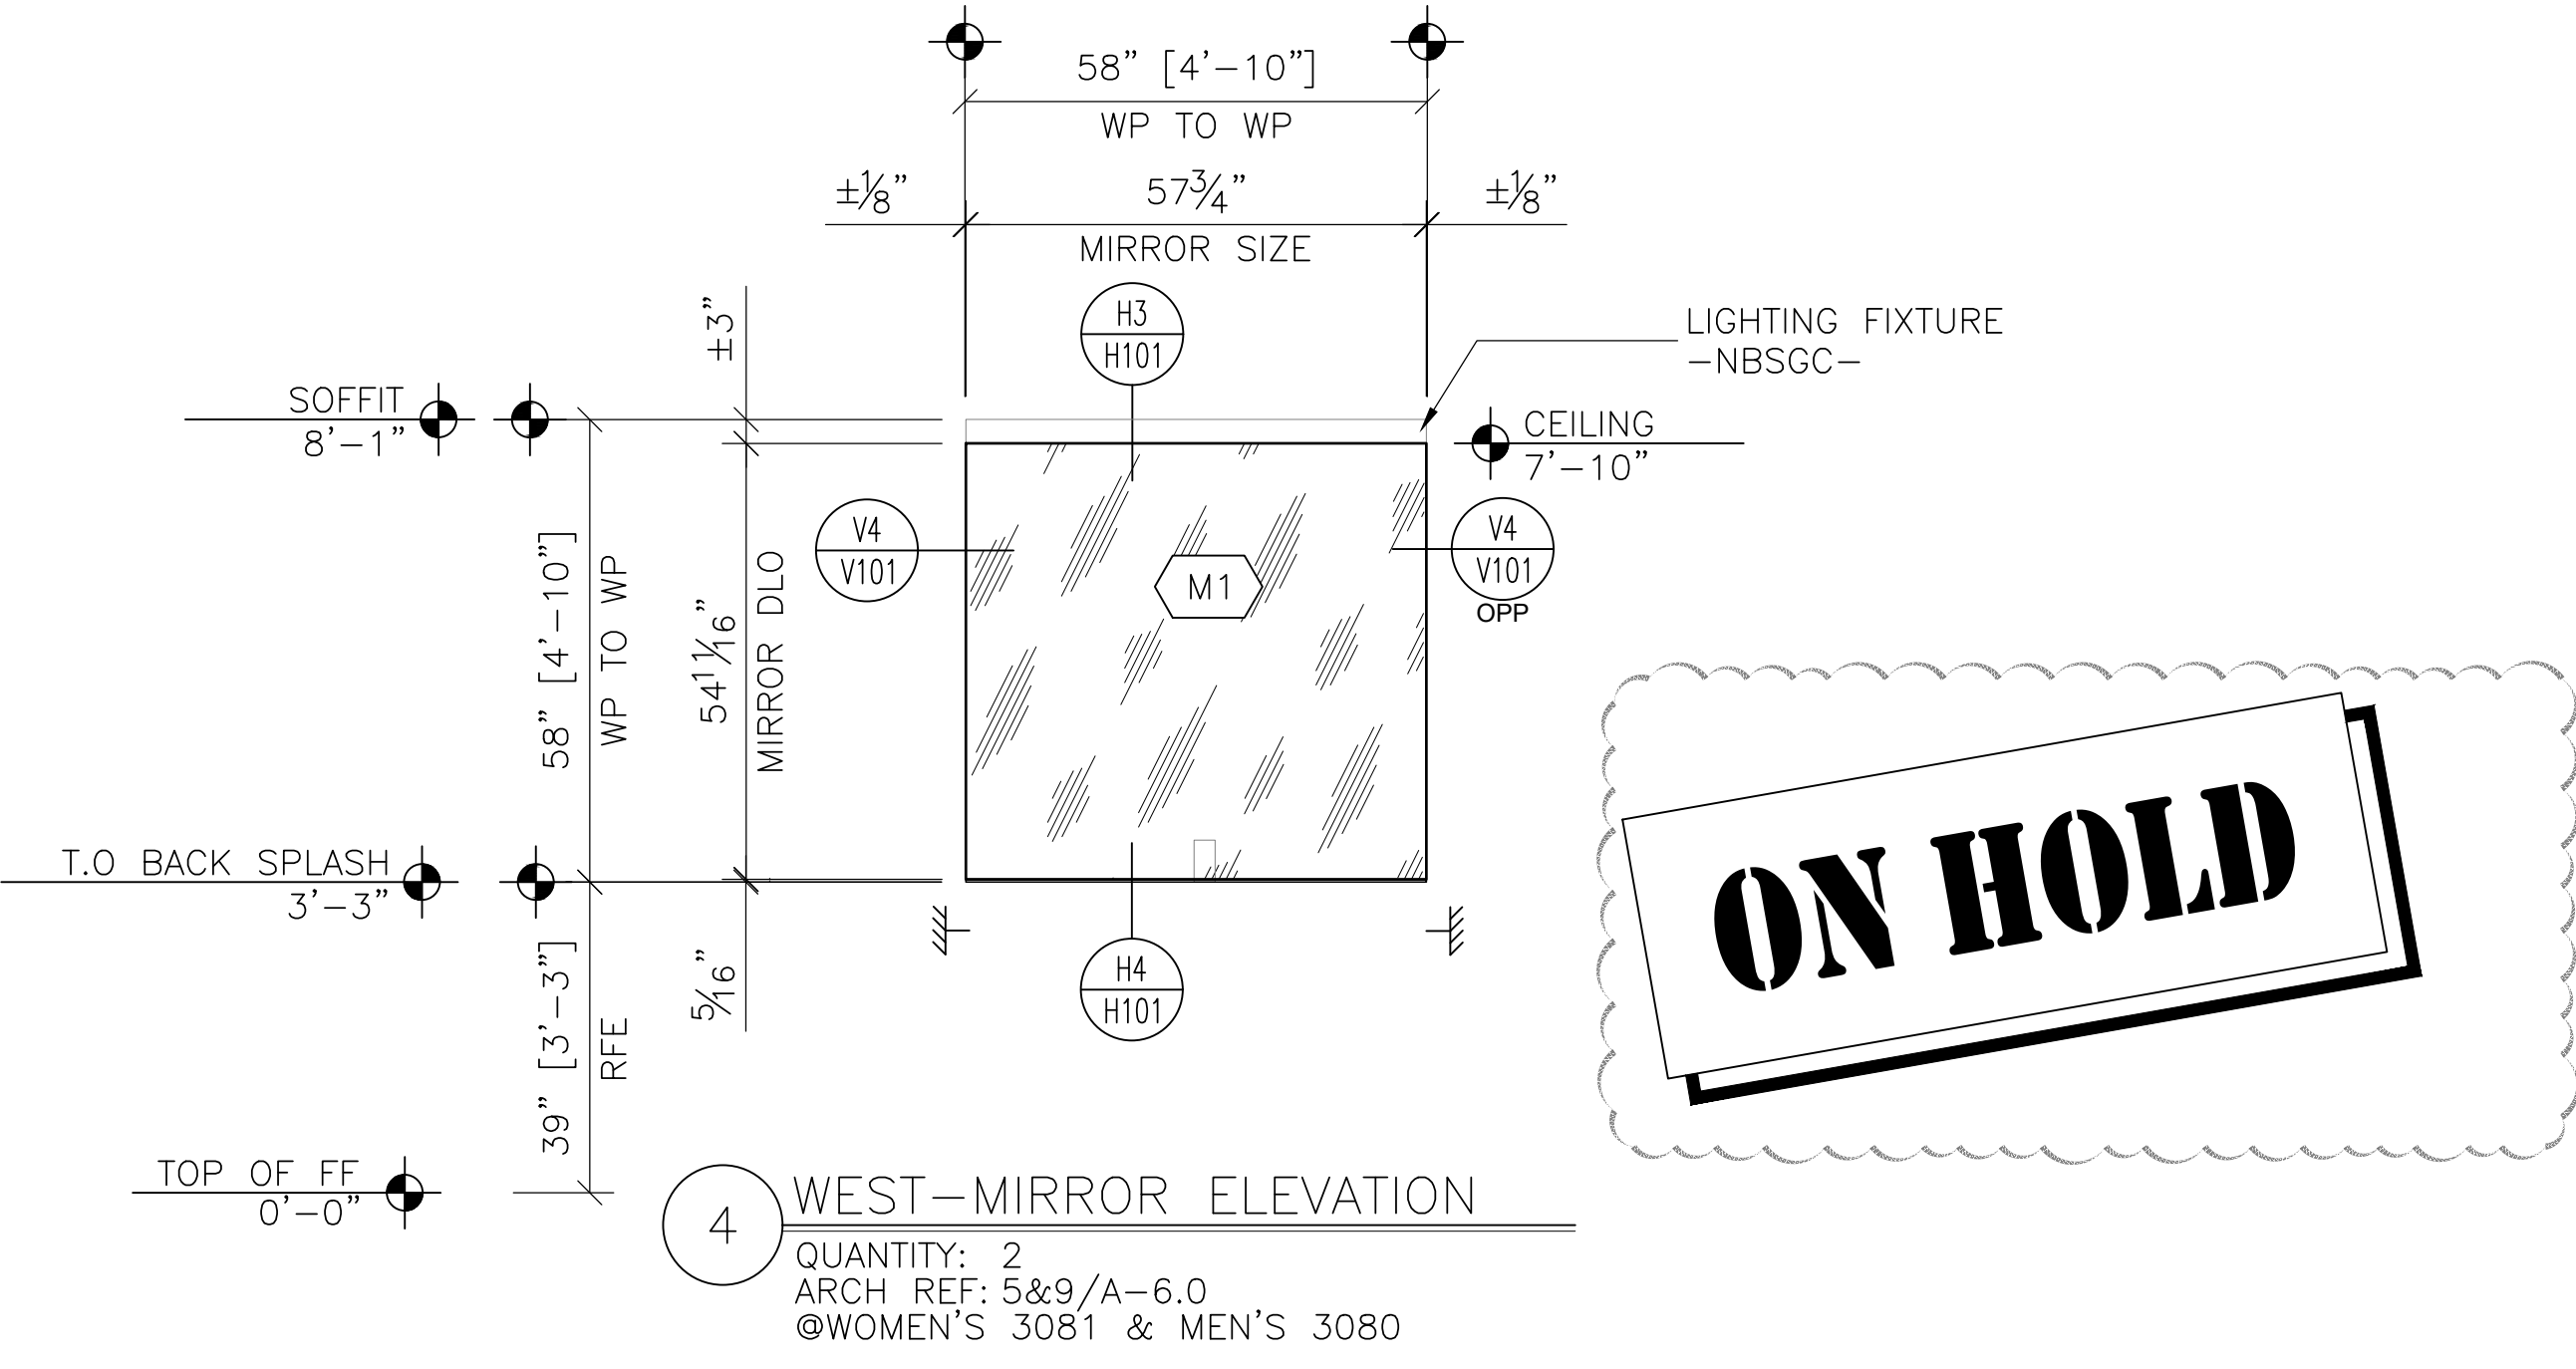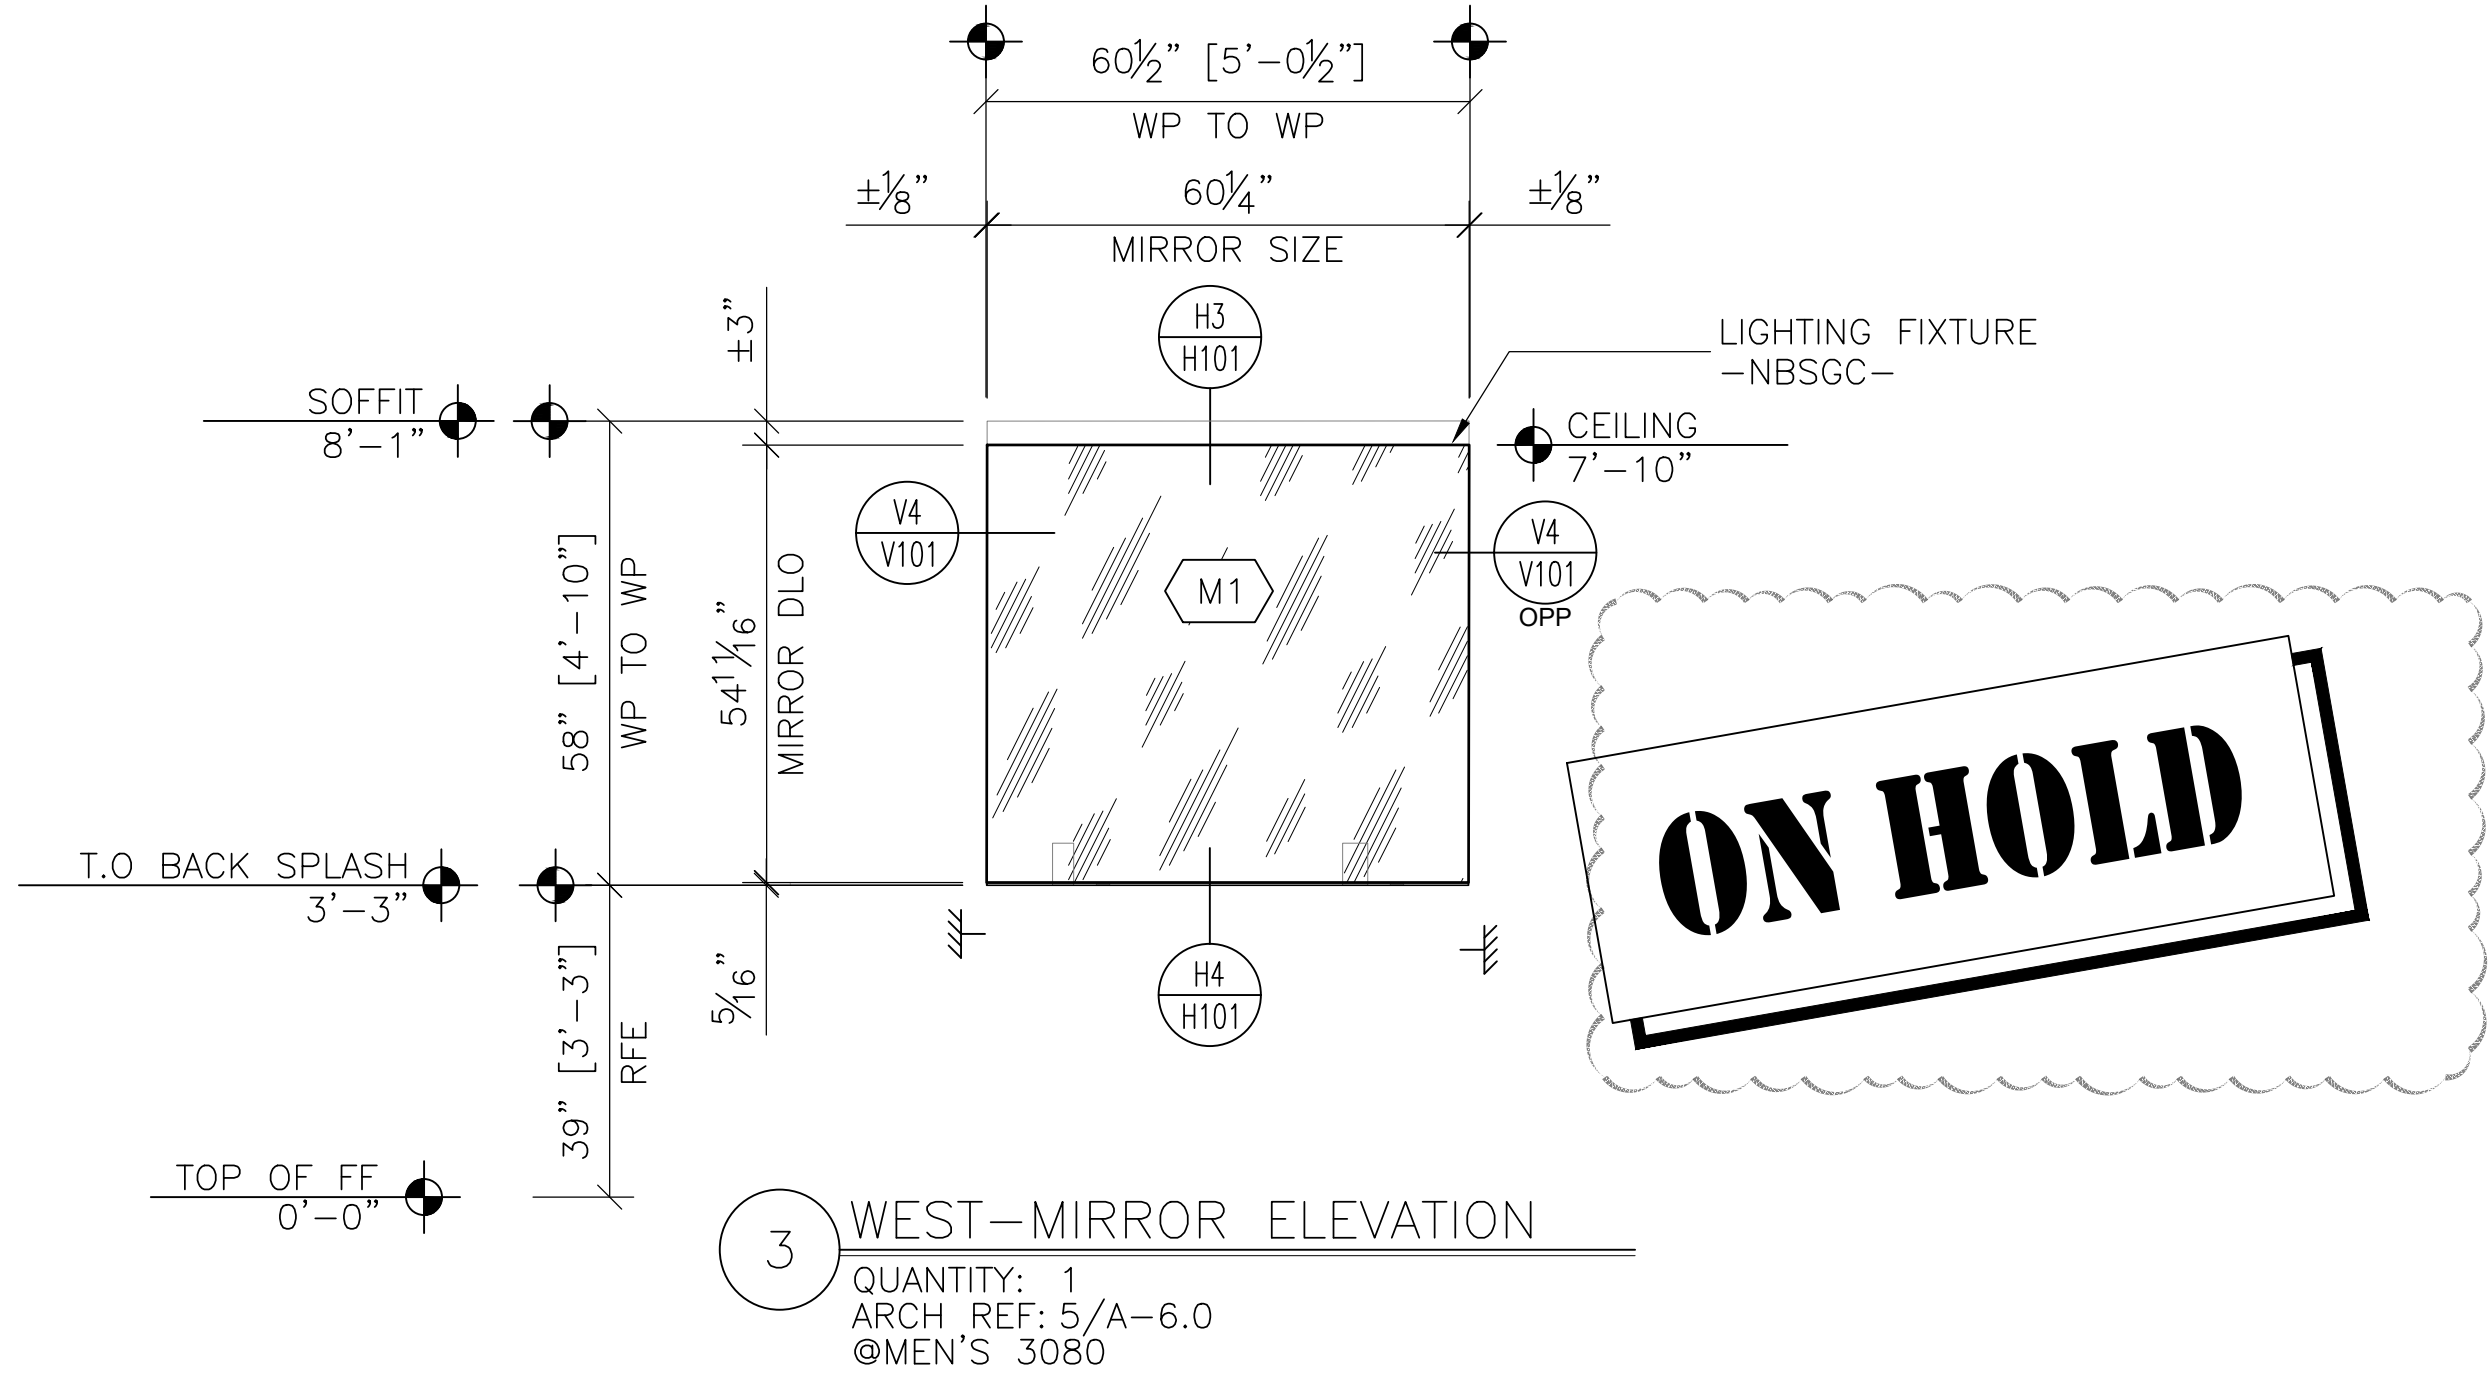

PROJECT	DESCRIPTION	BY	DATE	REV
CIBC	REVISED PER FAB/INSTALL & VIF	SM	02/06/26	01
ARCHITECT				
INTERIOR ARCHITECTS				
GENERAL CONTRACTOR				
STRUCTURE TONE				
PROJ NO	8859			
DATE	11/14/25			
DRAWN	SM			
CHECKED	SB/MO			
FILE NAME	8859 e 1			
SCALE	1/2"=1'-0"			
SHEET NUMBER	E102			

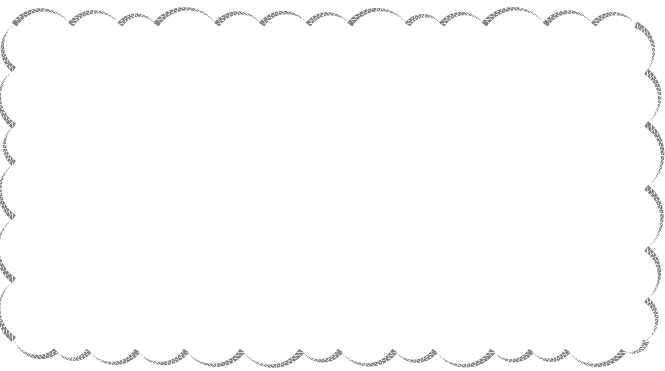


- M1


1/4" POLISH PLATE GLASS MIRRORS
- GL1

1/4" BACKPAINTED GALAXY ANNEALED GLASS -088000.03-GALAXY GLASS 1-4 14755G
- GL2

1/2" CLEAR TEMPERED GLASS

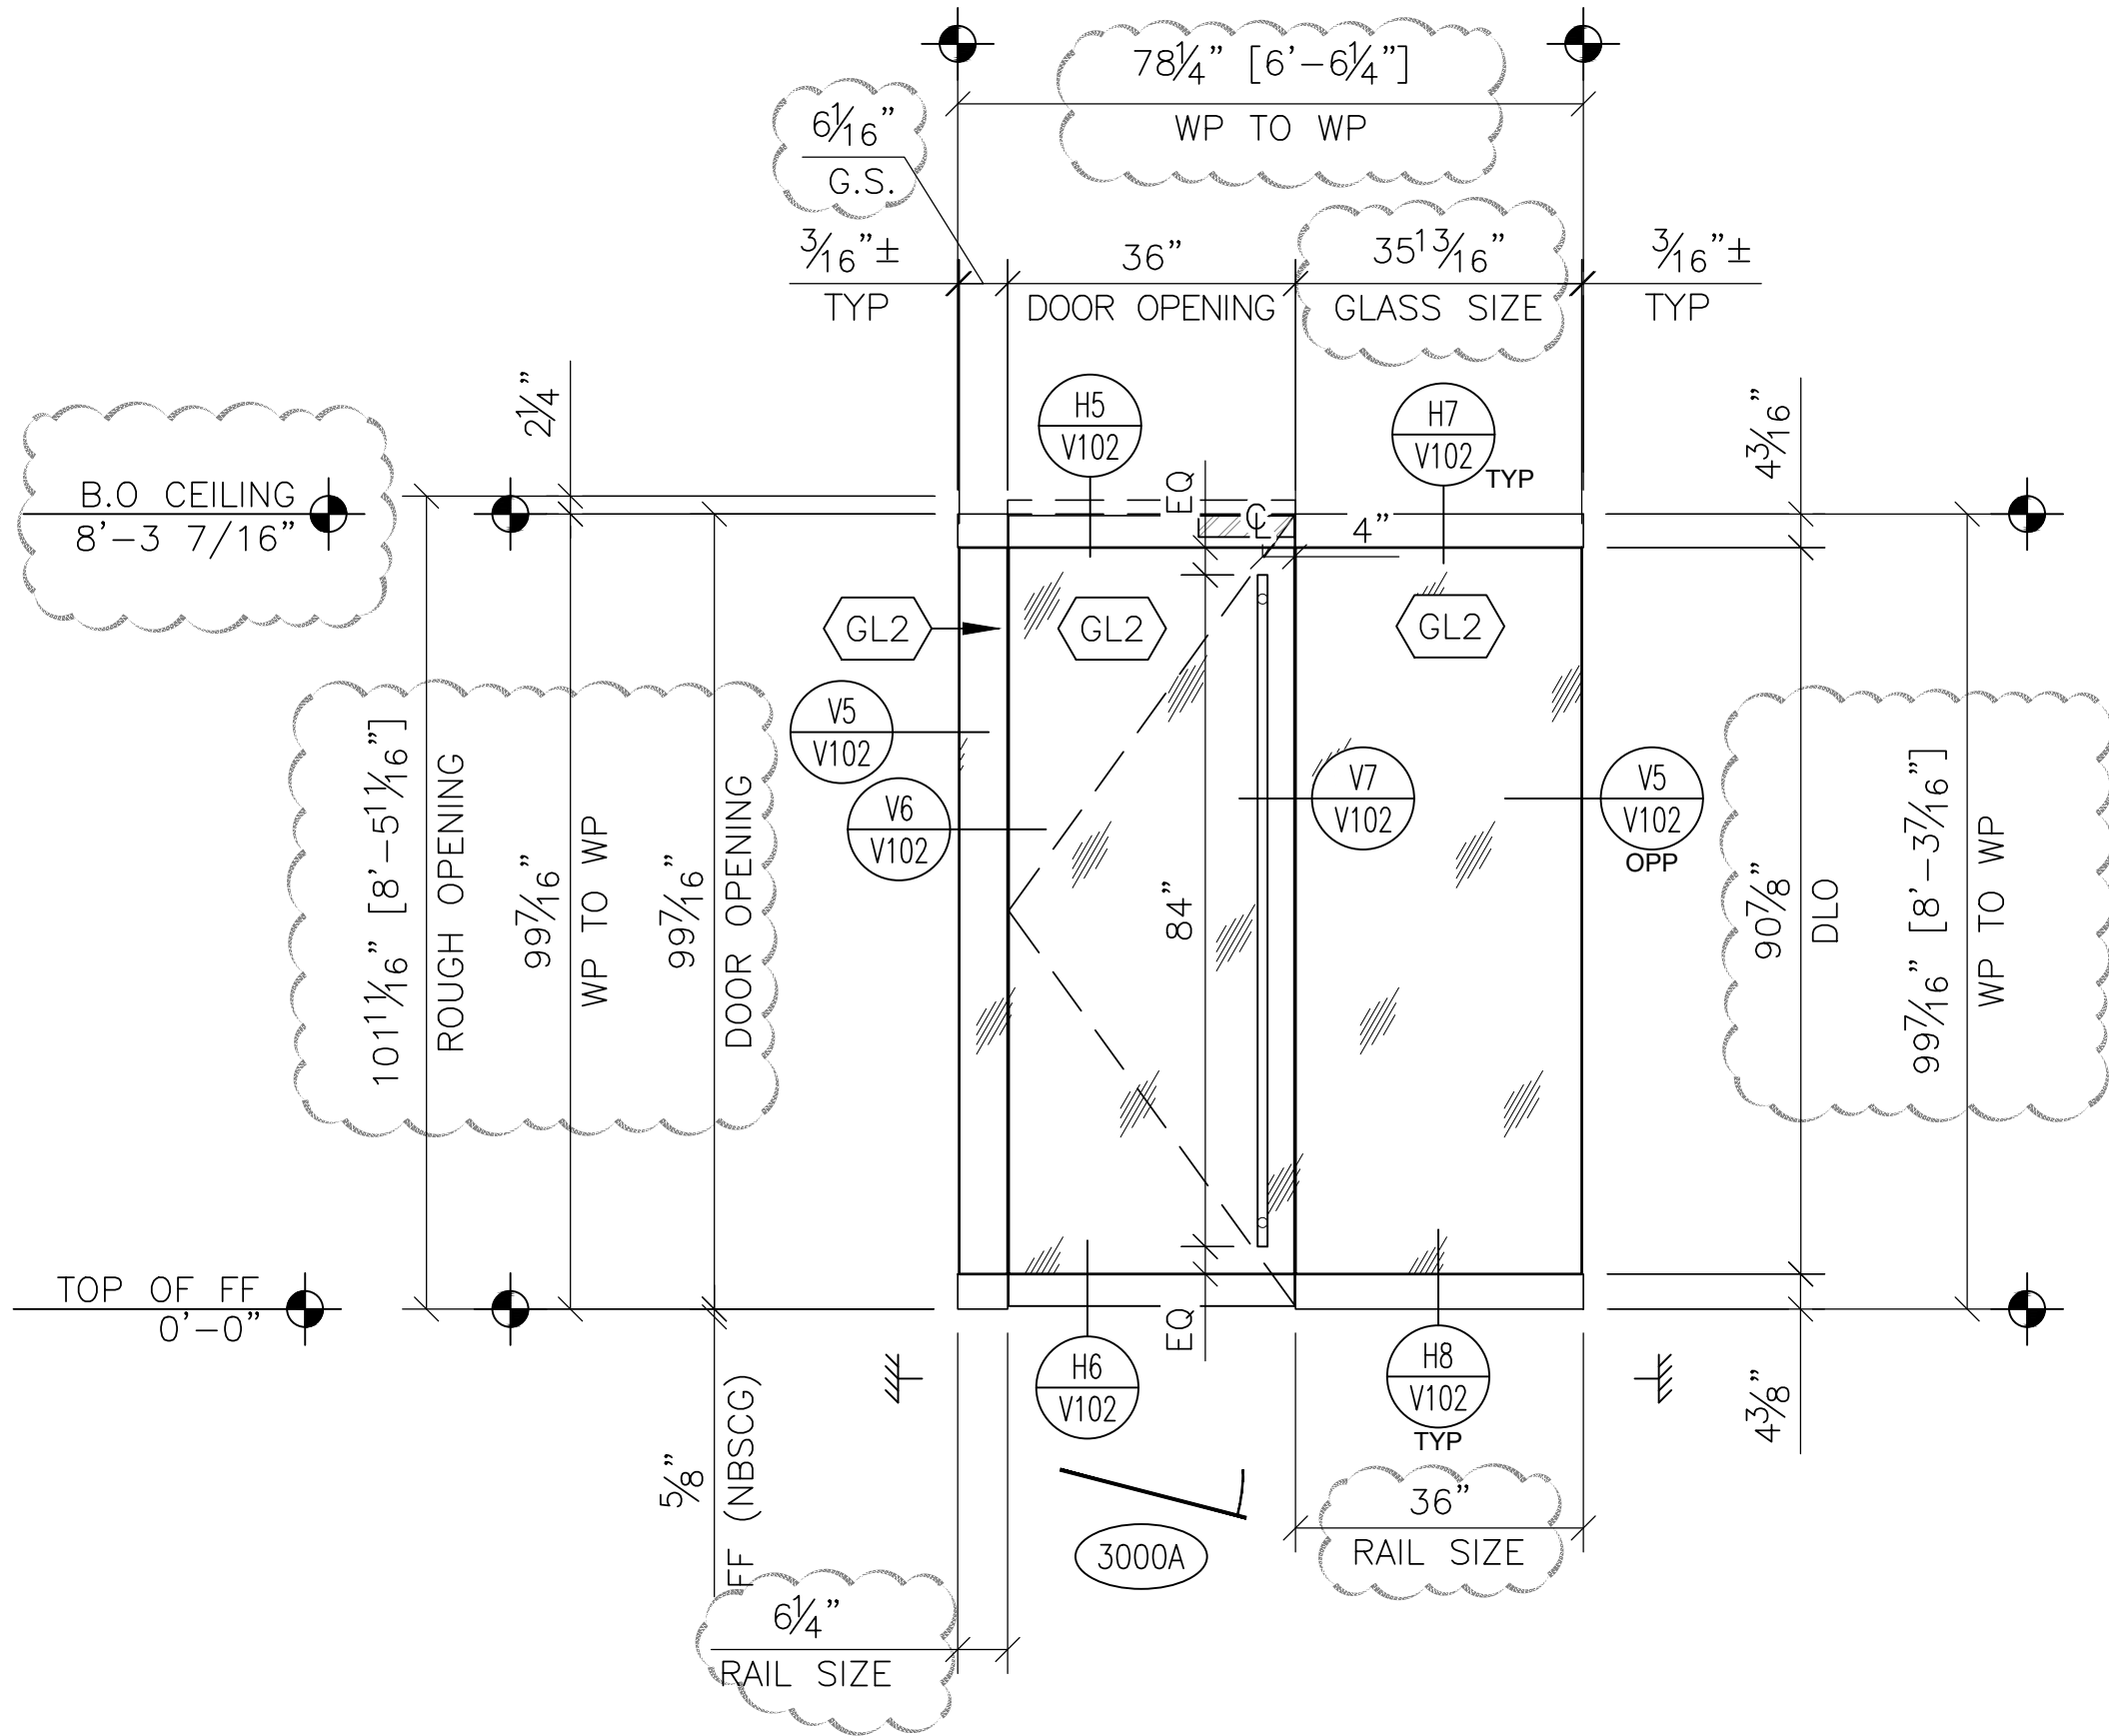


7 ELEVATION
QUANTITY: 1
ARCH. REF: NONE
@LOBBY 3000-NORTH

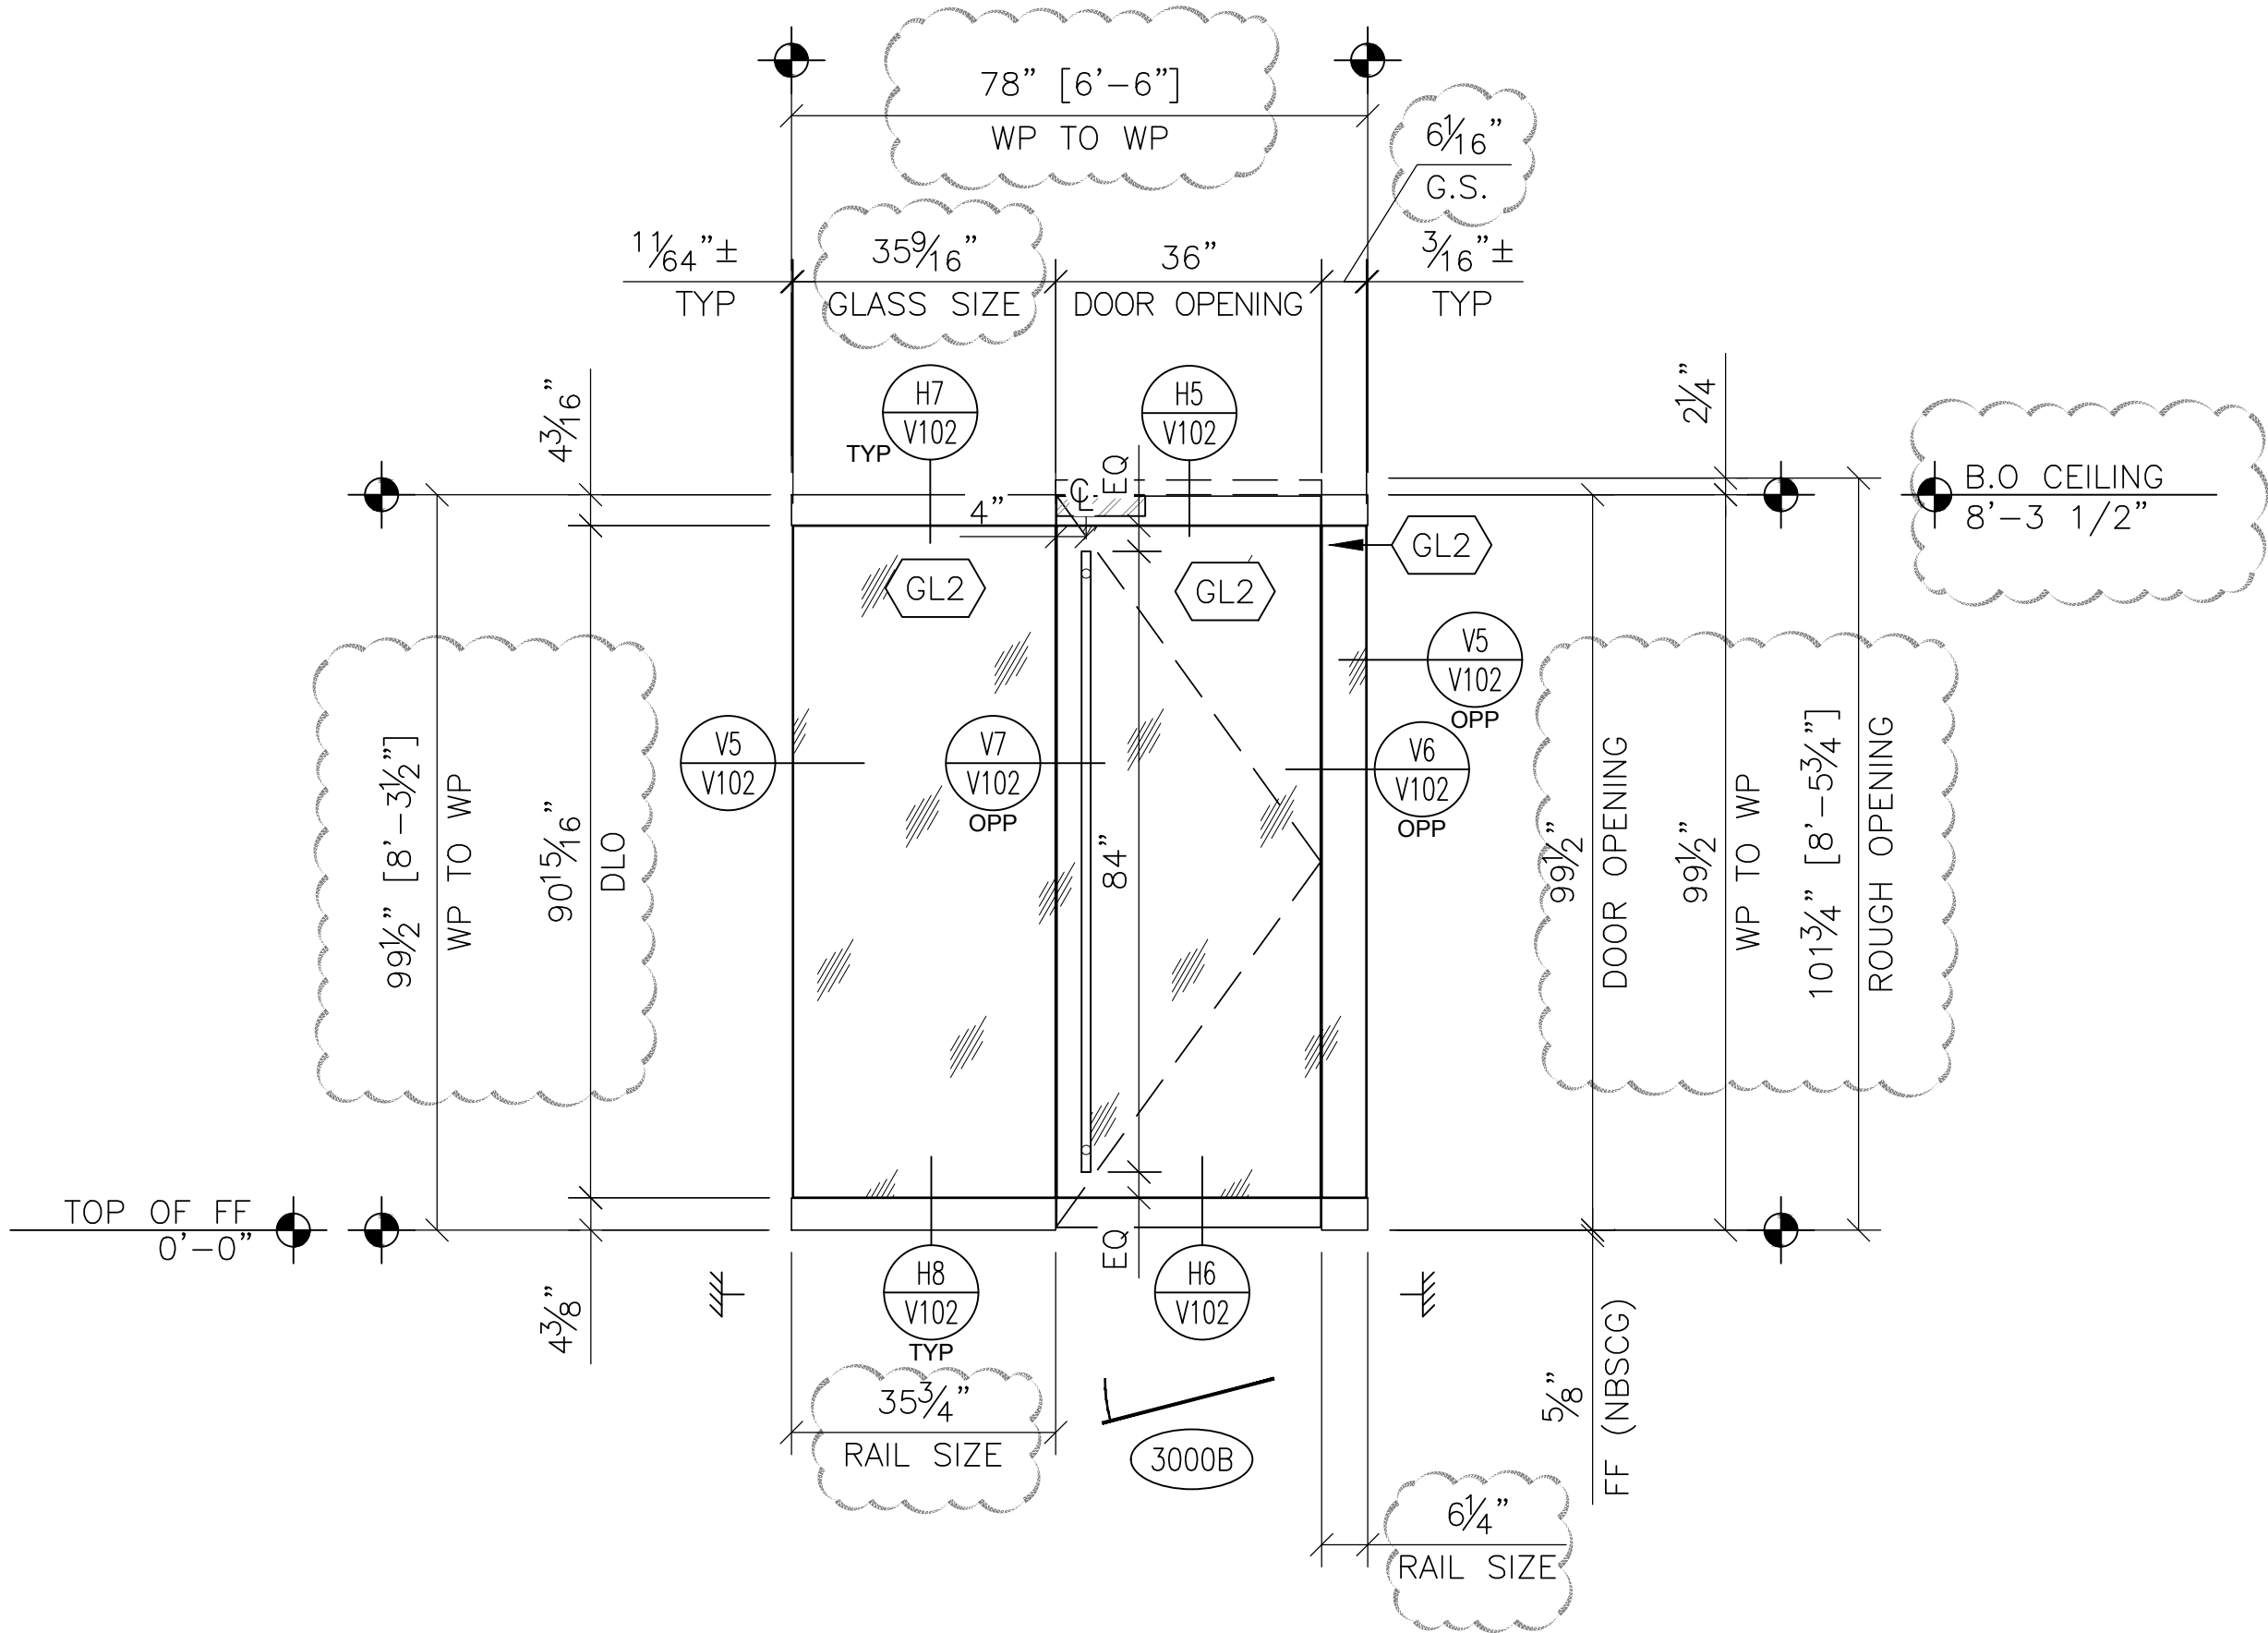


8 ELEVATION
QUANTITY: 1
ARCH. REF: NONE
@LOBBY 3000-SOUTH



PROJECT	DESCRIPTION	BY	DATE	REV
CIBC	REVISED PER FAB/INSTALL & VIF	SM	02/06/26	01
ARCHITECT				
INTERIOR ARCHITECTS				
GENERAL CONTRACTOR				
STRUCTURE TONE				
PROJ NO	8859			
DATE	11/14/25			
DRAWN	SM			
CHECKED	SB/MO			
FILE NAME	8859 e 1			
SCALE	1/2"=1'-0"			
SHEET NUMBER	E103			

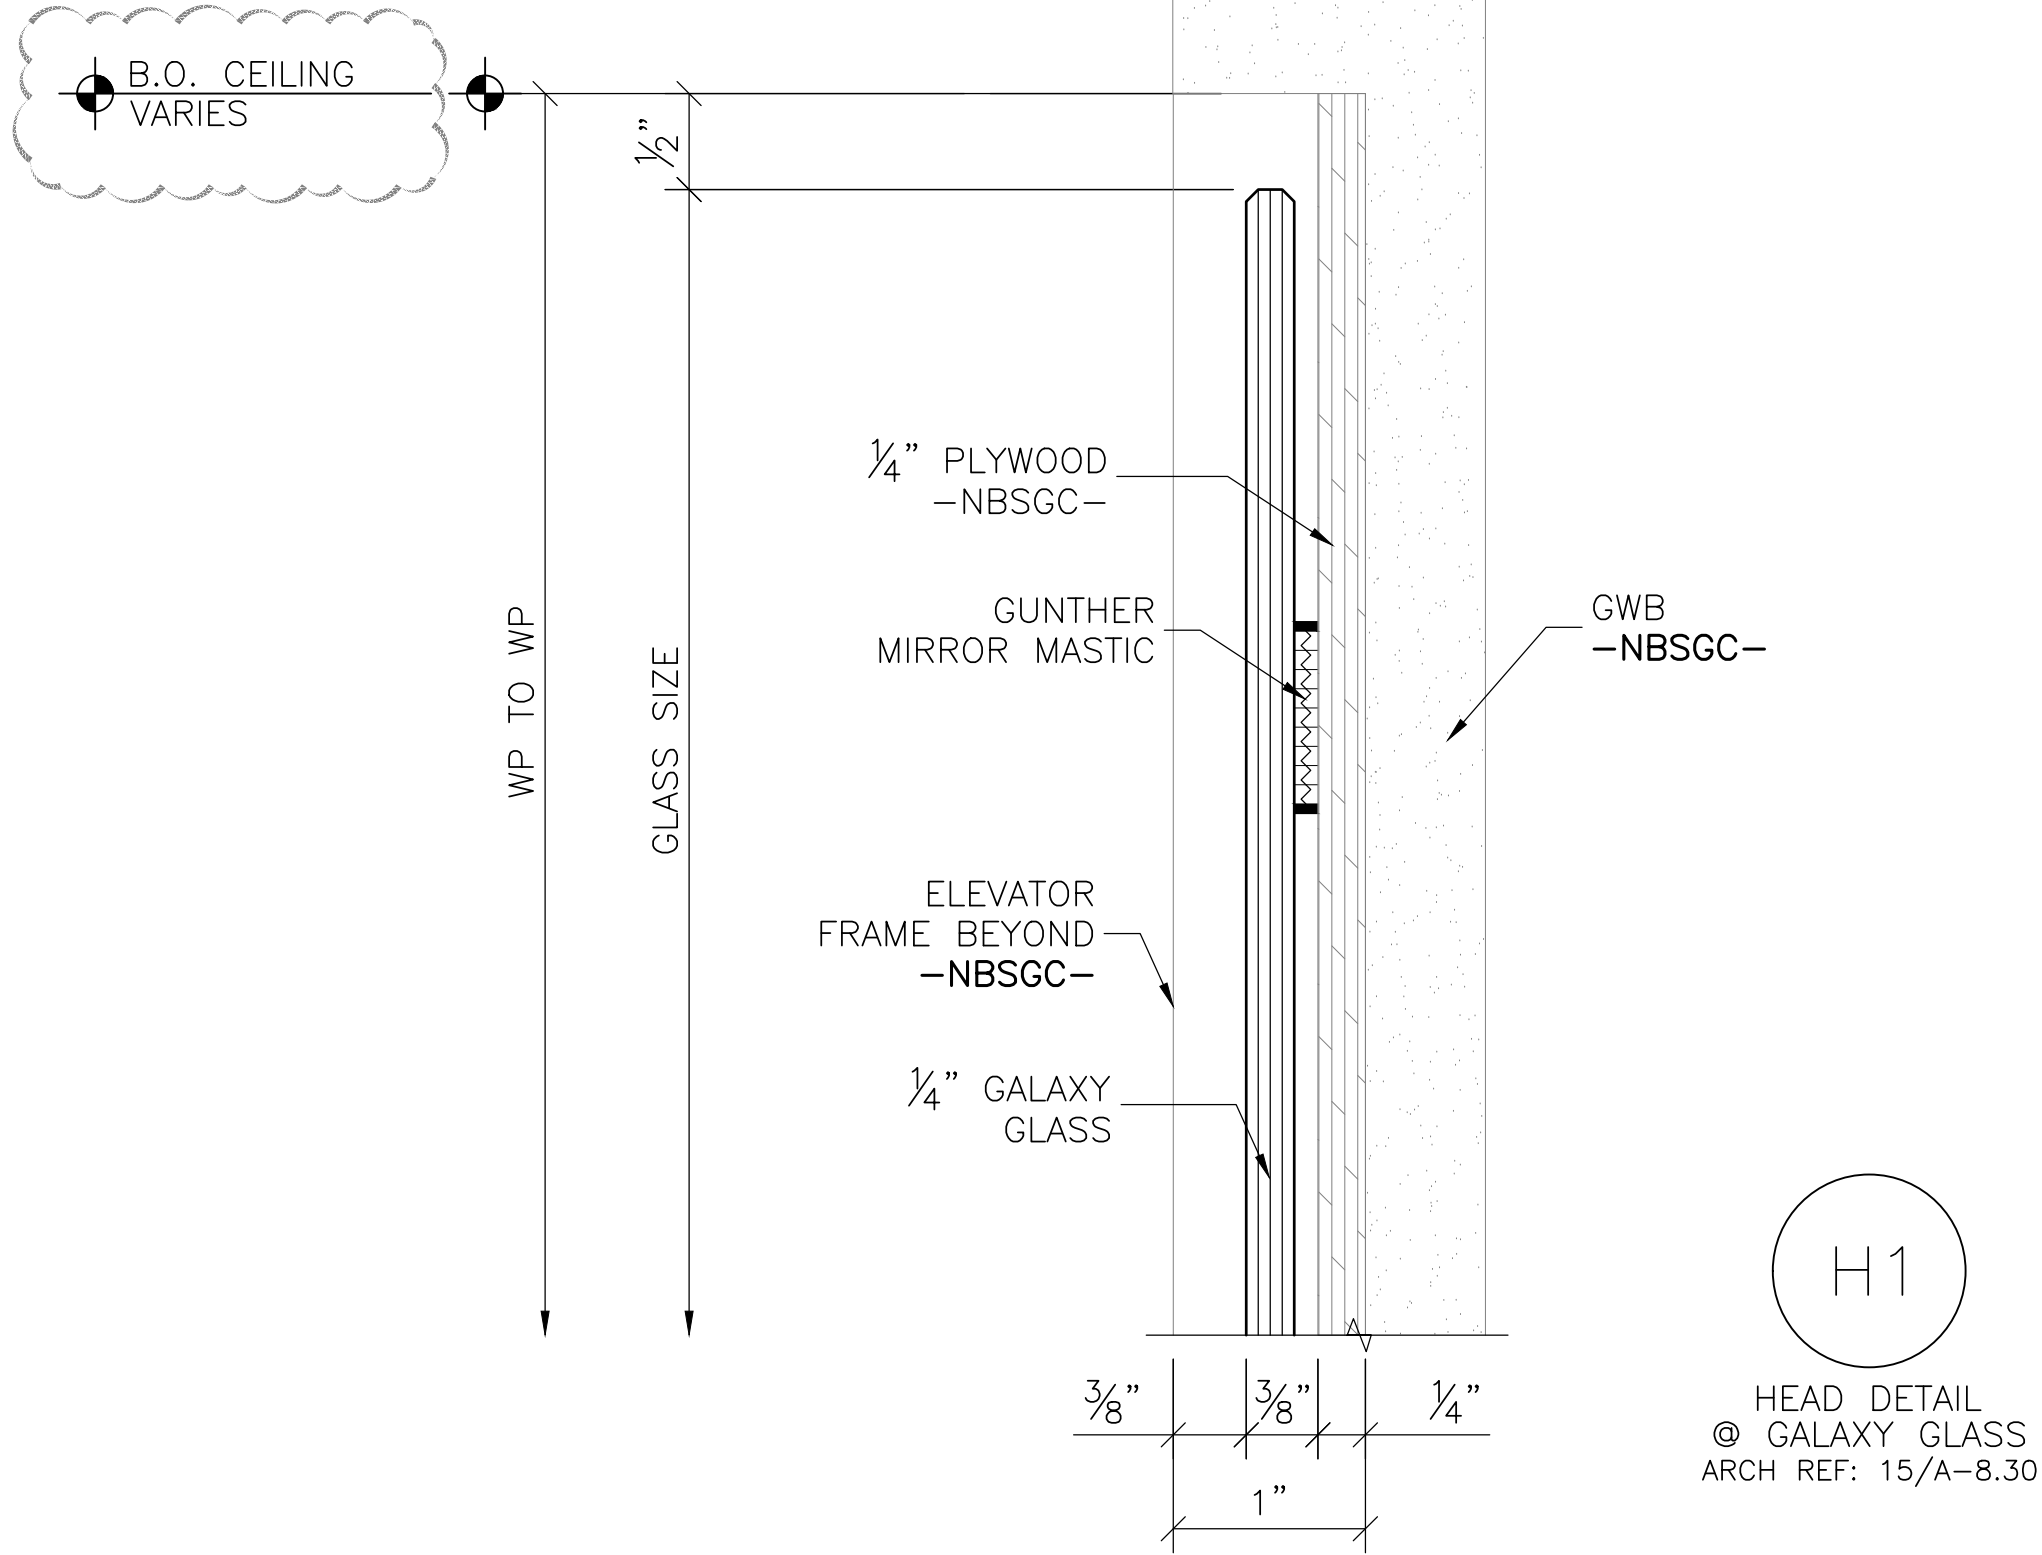

ARCH/GC NOTE:
AT BACKPAINTED GLASS LOCATIONS ADHERED TO PLYWOOD, THE PLYWOOD SHOULD BE PRIME PAINTED ONLY IN A COLOR (LIGHT OR DARK) BASED ON THE BACKPAINTED COLOR. THE PERIMETER WALLS SHOULD BE PAINTED THE FINISH WALL COLOR TO AVOID READ THRU OF THE PRIMER.

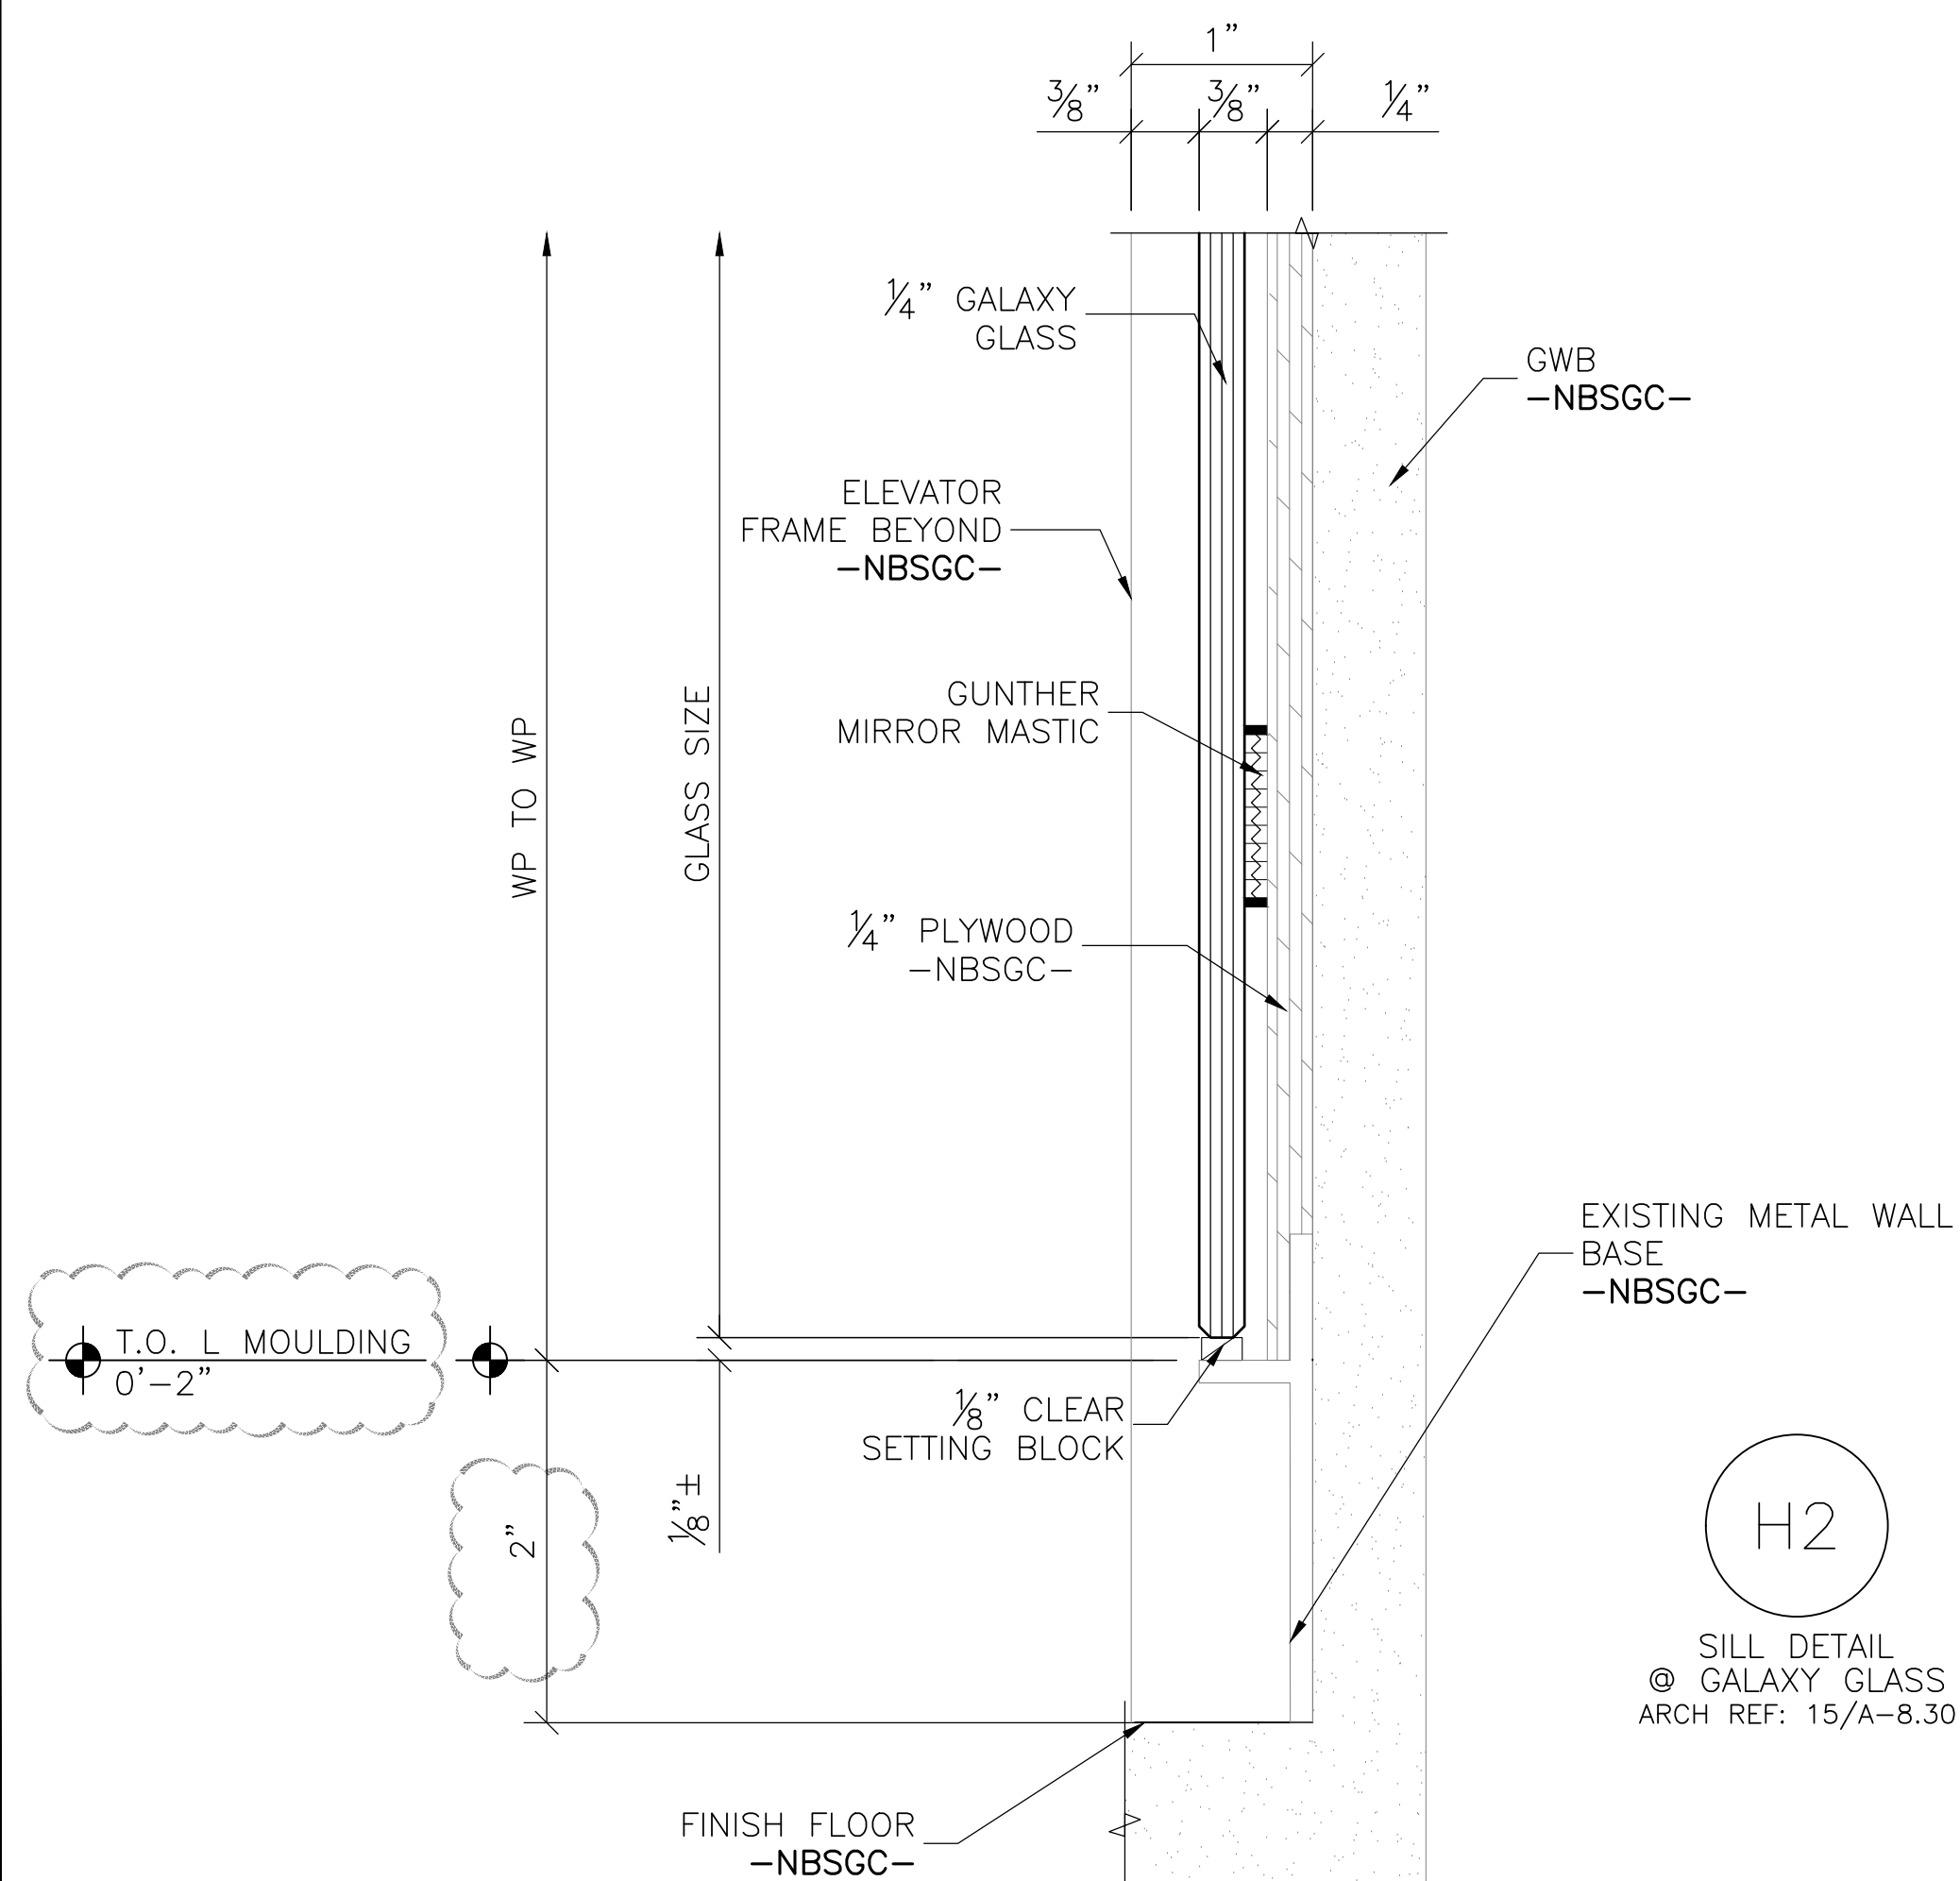

ARCHITECT/GC NOTE:
ALL MIRROR SUBSTRATES MUST BE UNFINISHED (WITHOUT PAINT OR PRIMER) TO ACCEPT GUNTHER PRIME-N-SEAL® REQUIRED PRIMER.

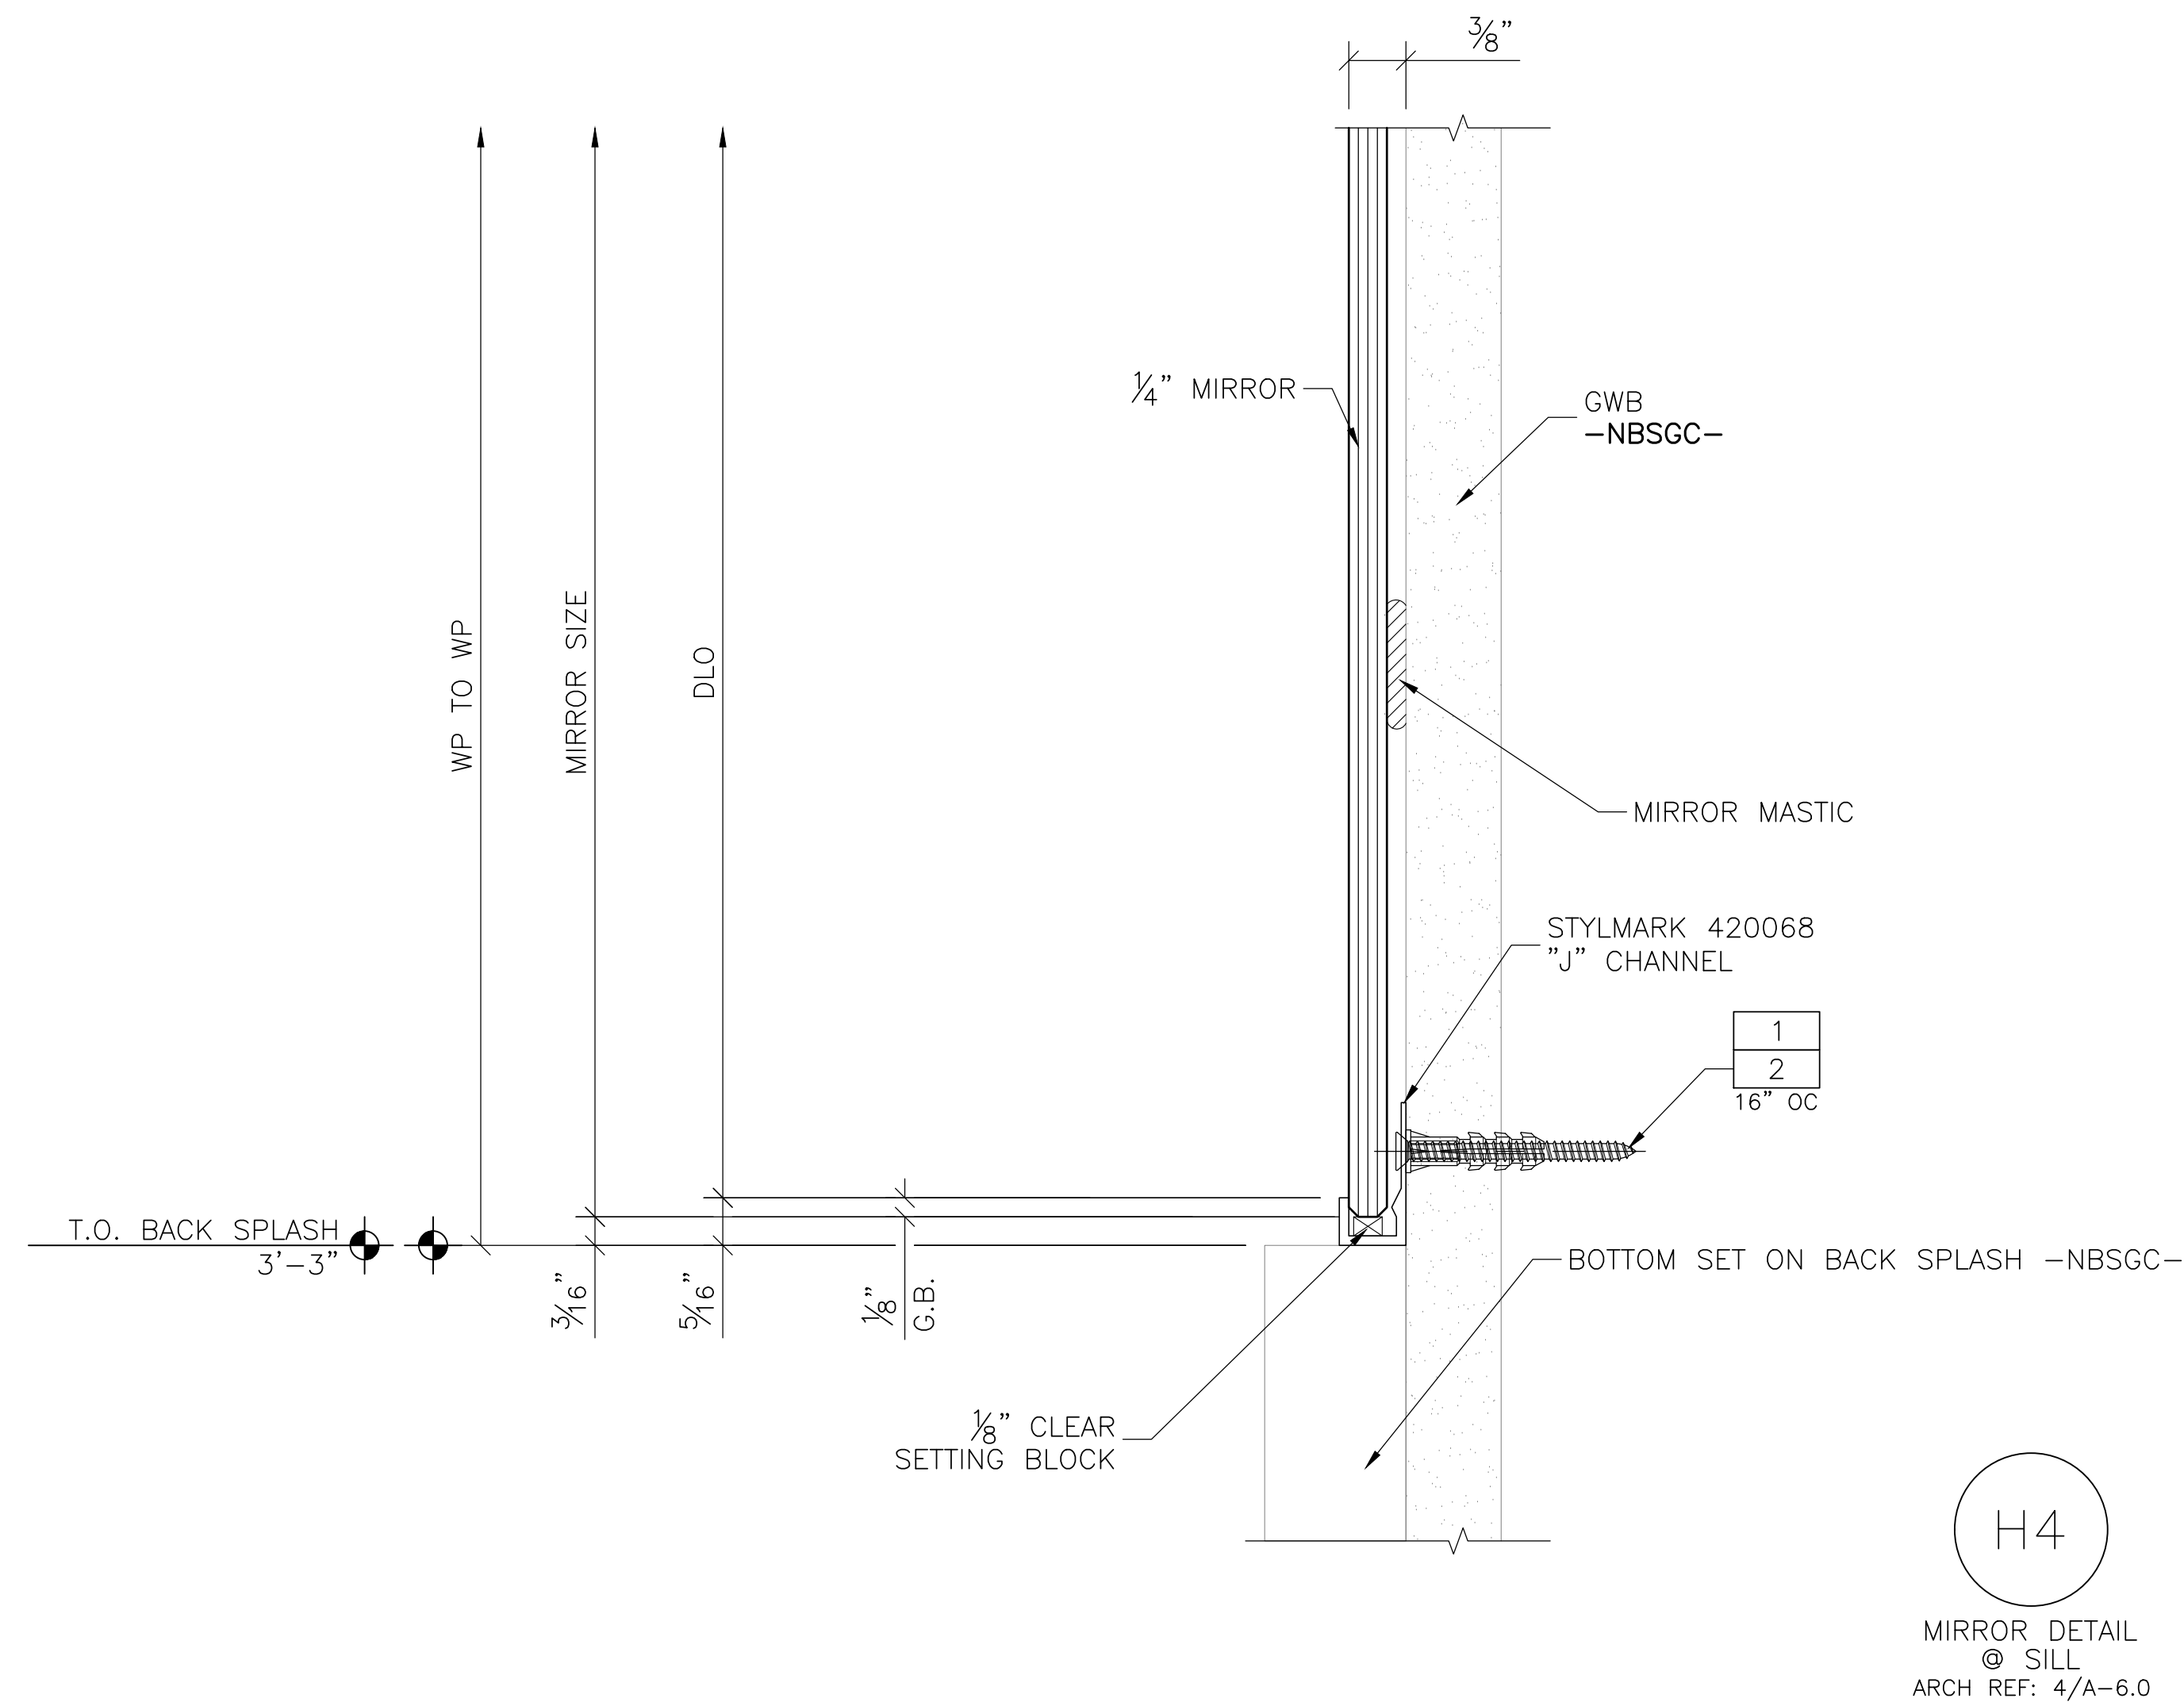
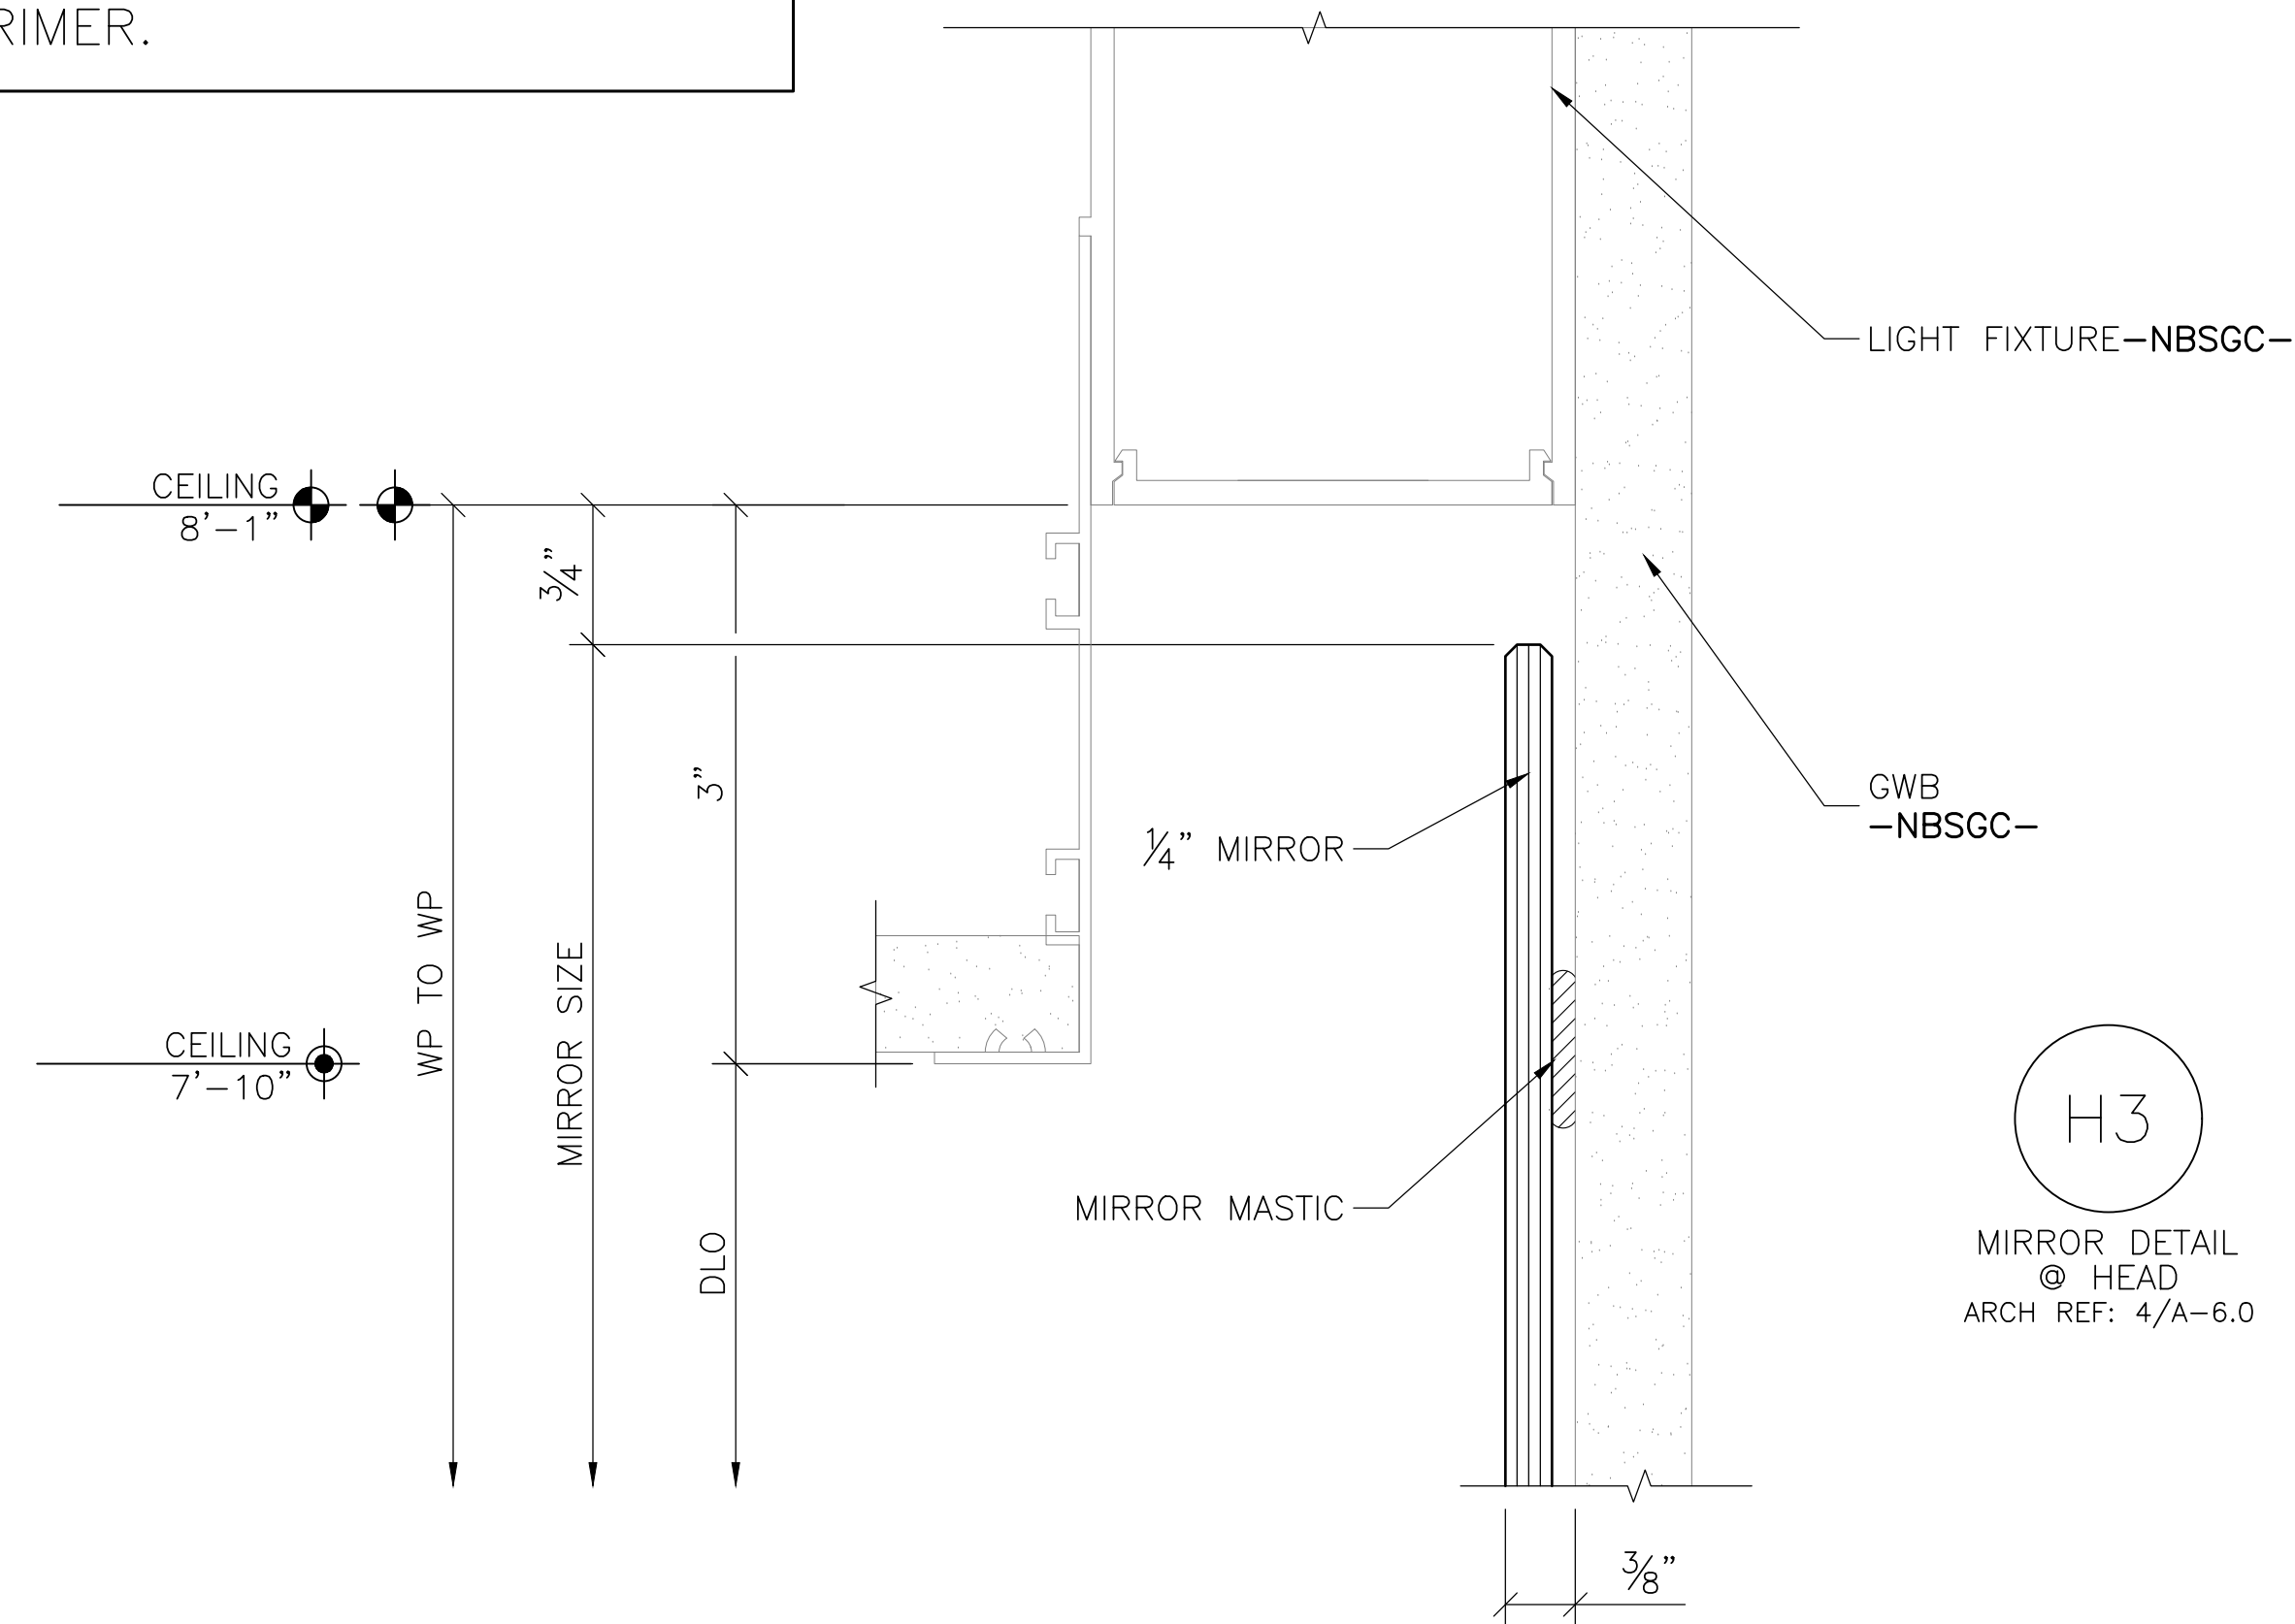




SALEM GLASS COMPANY
3 Technology Way, Salem, MA 01970
Phone# (978)744-5177 Fax# (978)745-4036

PROJECT	DESCRIPTION	BY	DATE	REV
CIBC	REVISED PER FAB/INSTALL & VIF	SM	02/06/26	01
ARCHITECT				
INTERIOR ARCHITECTS				
GENERAL CONTRACTOR				
STRUCTURE TONE				
PROJ NO	8859			
DATE	11/14/25			
DRAWN	SM			
CHECKED	SB/MO			
FILE NAME	8859 h 1			
SCALE	FULL SCALE			
SHEET NUMBER	H101			



PROJECT	PROJ NO	8859	REV	DATE	BY	DESCRIPTION
CIBC	DATE	11/14/2	01	02/06/26	SM	REVISED PER FAB/INSTALL & VIF
ARCHITECT	DRAWN	SM				
INTERIOR ARCHITECTS	CHECKED	SB/MO				
GENERAL CONTRACTOR	FILE NAME	8859 h				
STRUCTURE TONE	SCALE	FULL SCA				
	SHEET NUMBER	H102				

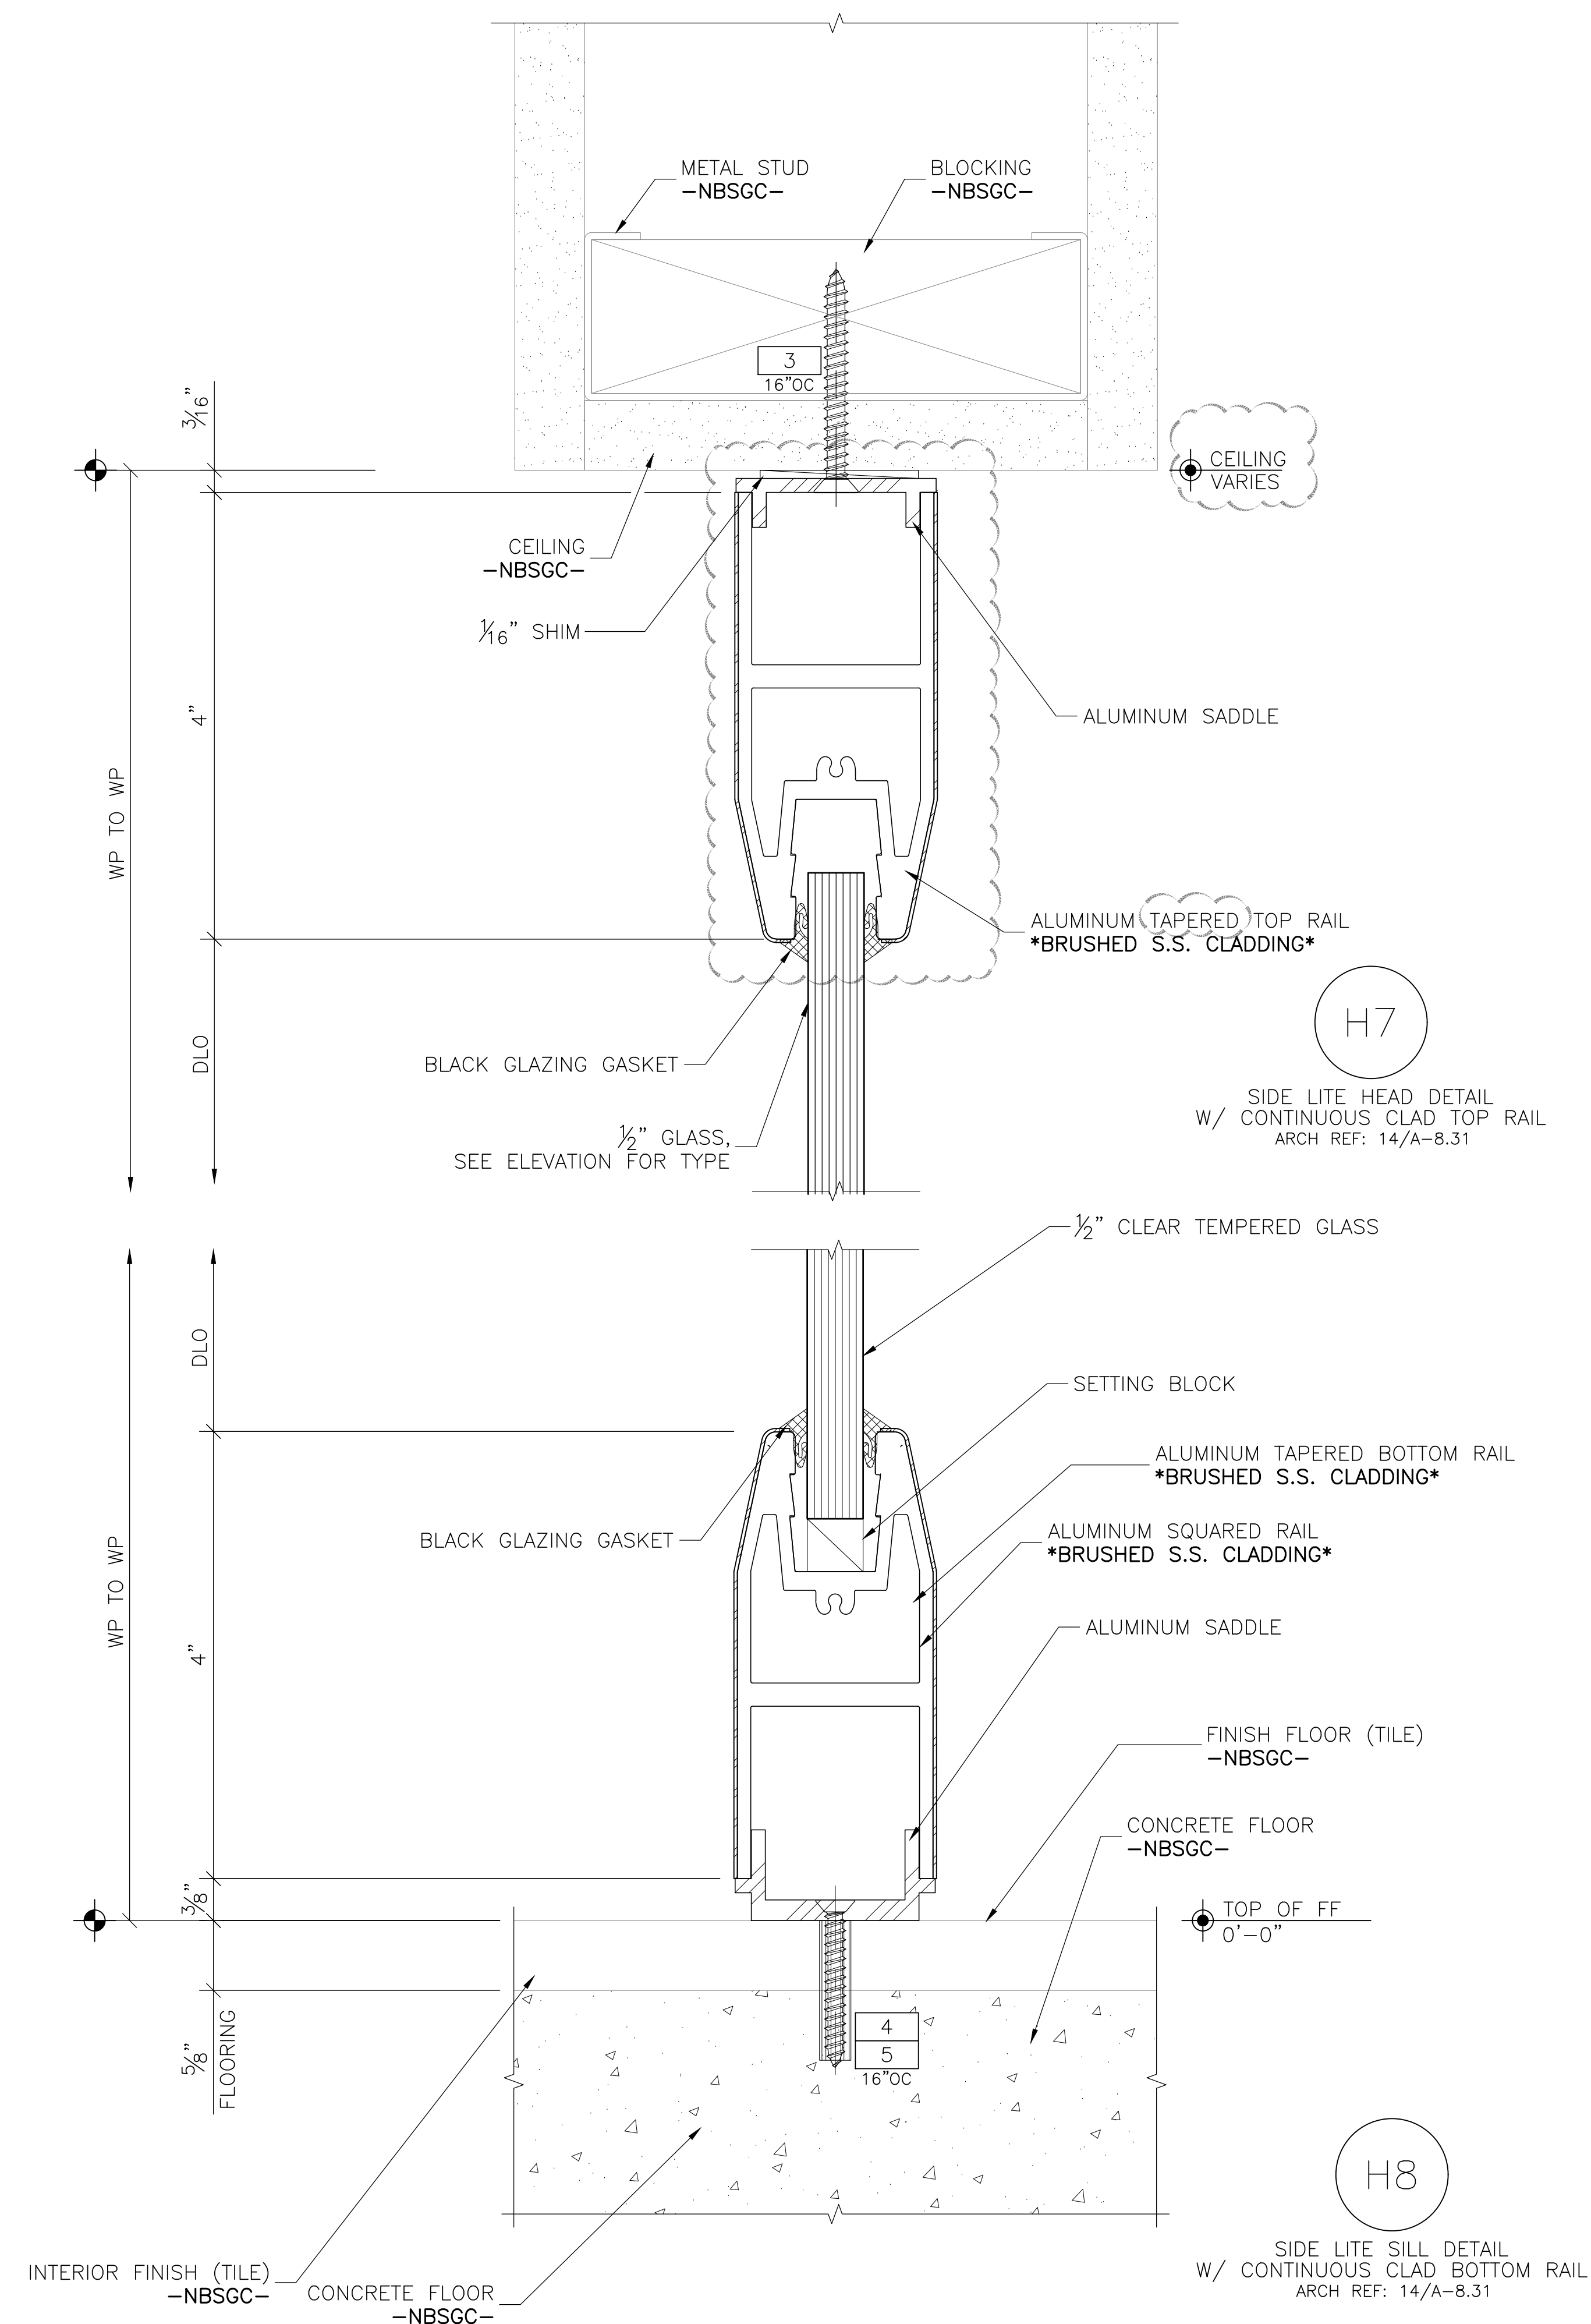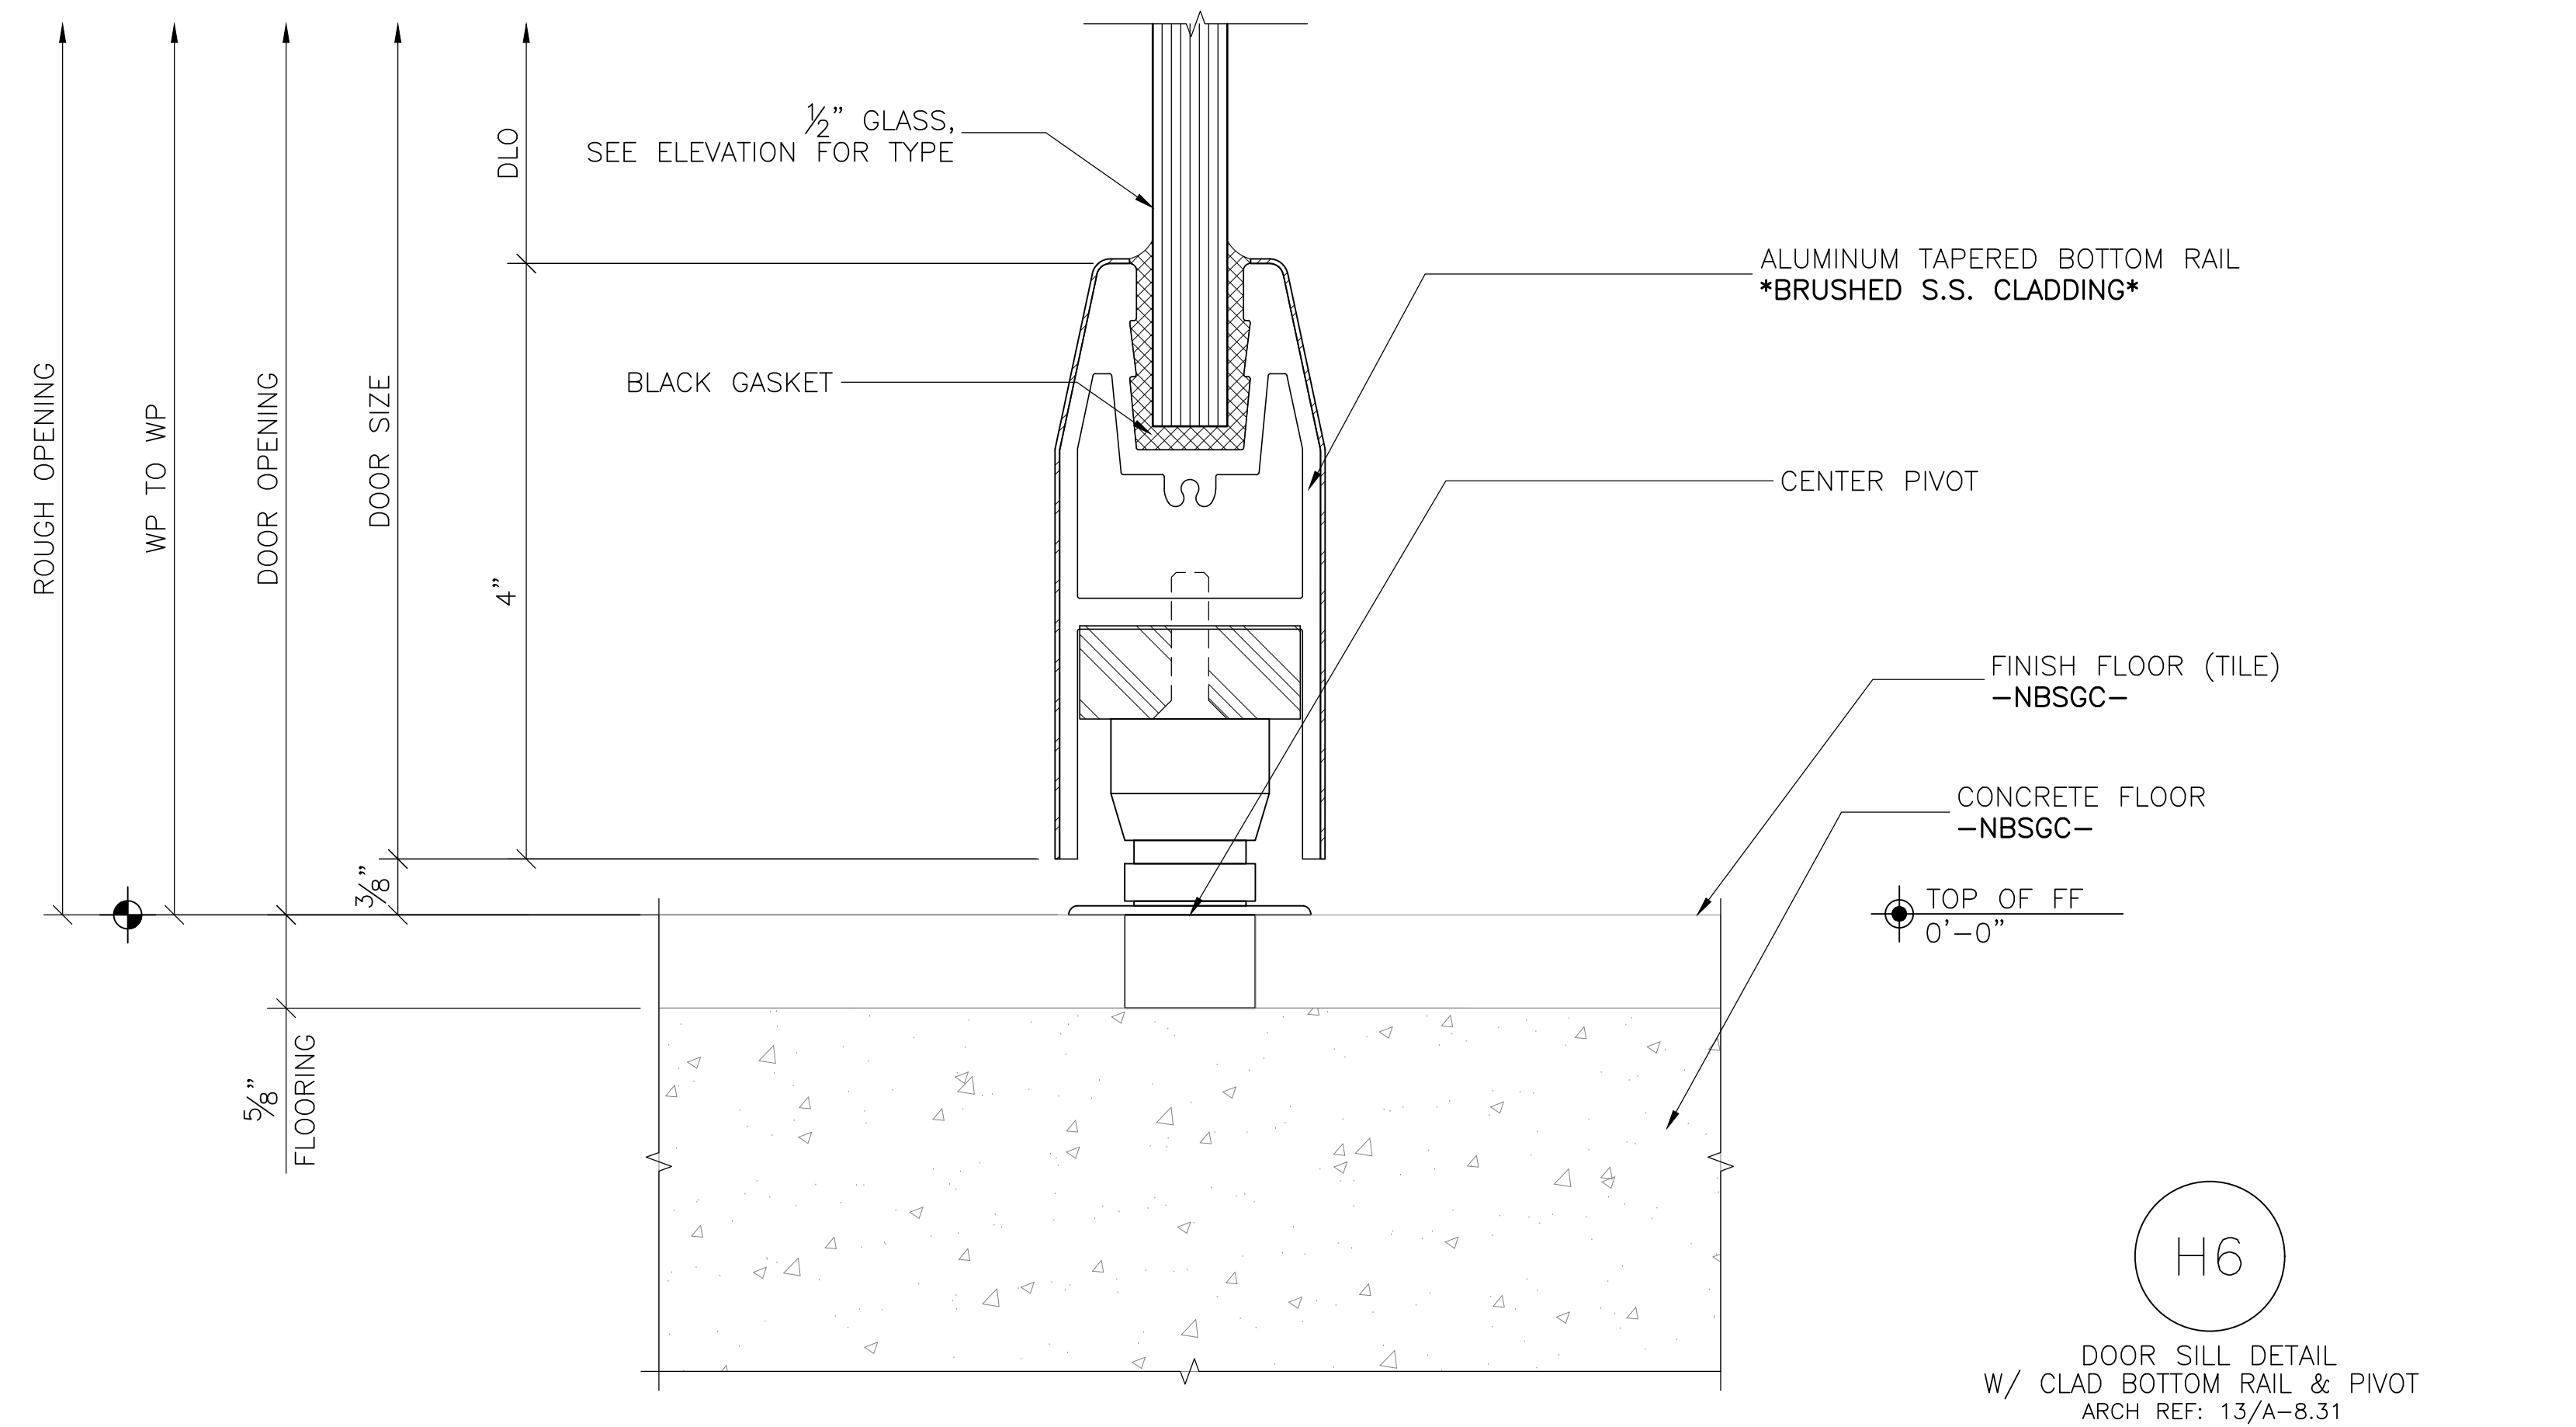

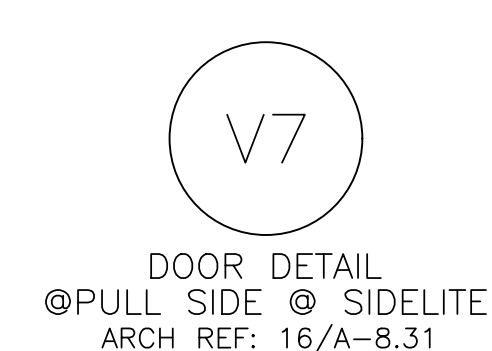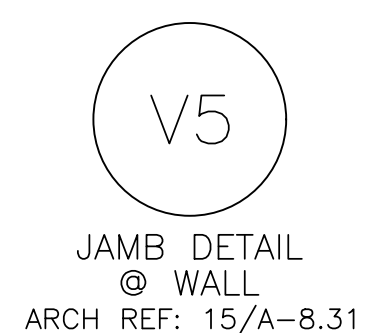

PROJECT	PROJ NO	8859	REV	DATE	BY	DESCRIPTION
CIBC	DATE	11/14/25				
ARCHITECT	DRAWN	SM				
INTERIOR ARCHITECTS	CHECKED	SB/MO				
GENERAL CONTRACTOR	FILE NAME	8859 v 1				
STRUCTURE TONE	SCALE	FULL SCALE				
	SHEET NUMBER	V102				