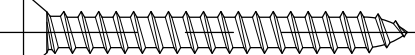



INTERIOR GLAZING


[illegible]

INTERIOR GLAZING FASTENER INDEX

FASTENER#:	1	IMAGE:
PART#: FASTENAL #31564 . .		 SEE NOTE ON DETAIL
DESCRIPTION: #8-15 X 1" PFH TYPE-A SMS *ZINC		

FASTENER#:	2	IMAGE:
PART#: FASTENAL #1173058 . .		
DESCRIPTION: #12-11 X 2" PFH TYPE-A SMS *18-8SS		

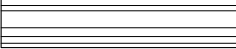FASTENER#:	3	IMAGE:
PART#: SGC INVENTORY #FA083 FASTENAL #50985 . .		 REMOVE HERE... ADD "SGC INVENTORY" HERE
DESCRIPTION: #10/#12 GREEN MASONRY PLUG *PLASTIC		

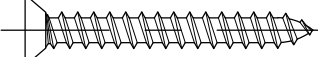FASTENER#:	4	IMAGE:
PART#: FASTENAL #1173036 . .		
DESCRIPTION: #10-12 x 1-1/2" PFH TYPE-A SMS *18-8SS		

SG

EST. 1920

SALEM GLASS COMPANY

3 Technology Way, Salem, MA 01970
Phone# (978)744-5577 Fax# (978)745-4036

PROJECT	KIRKLAND & ELLIS	PROJ NO	8901
ARCHITECT	HO&K	DATE	WORKING
GENERAL CONTRACTOR	STRUCTURE TONE, INC	DRAWN	SM
		CHECKED	SB/MO
		FILE NAME	8109 c 1
		SCALE	NO SCALE
		SHEET NUMBER	C102




SALEM GLASS COMPANY
3 Technology Way, Salem, MA 01970
Phone# (978)744-5177 Fax# (978)745-4036

REV	DATE	BY	DESCRIPTION

PROJECT	KIRKLAND & ELLIS
ARCHITECT	HO&K
GENERAL CONTRACTOR	STRUCTURE TONE, INC

PROJ NO	8901
DATE	WORKING
DRAWN	SM
CHECKED	SB/MO
FILE NAME	8109 p 1
SCALE	1/8"=1'-0"

SHEET NUMBER	P101
--------------	------

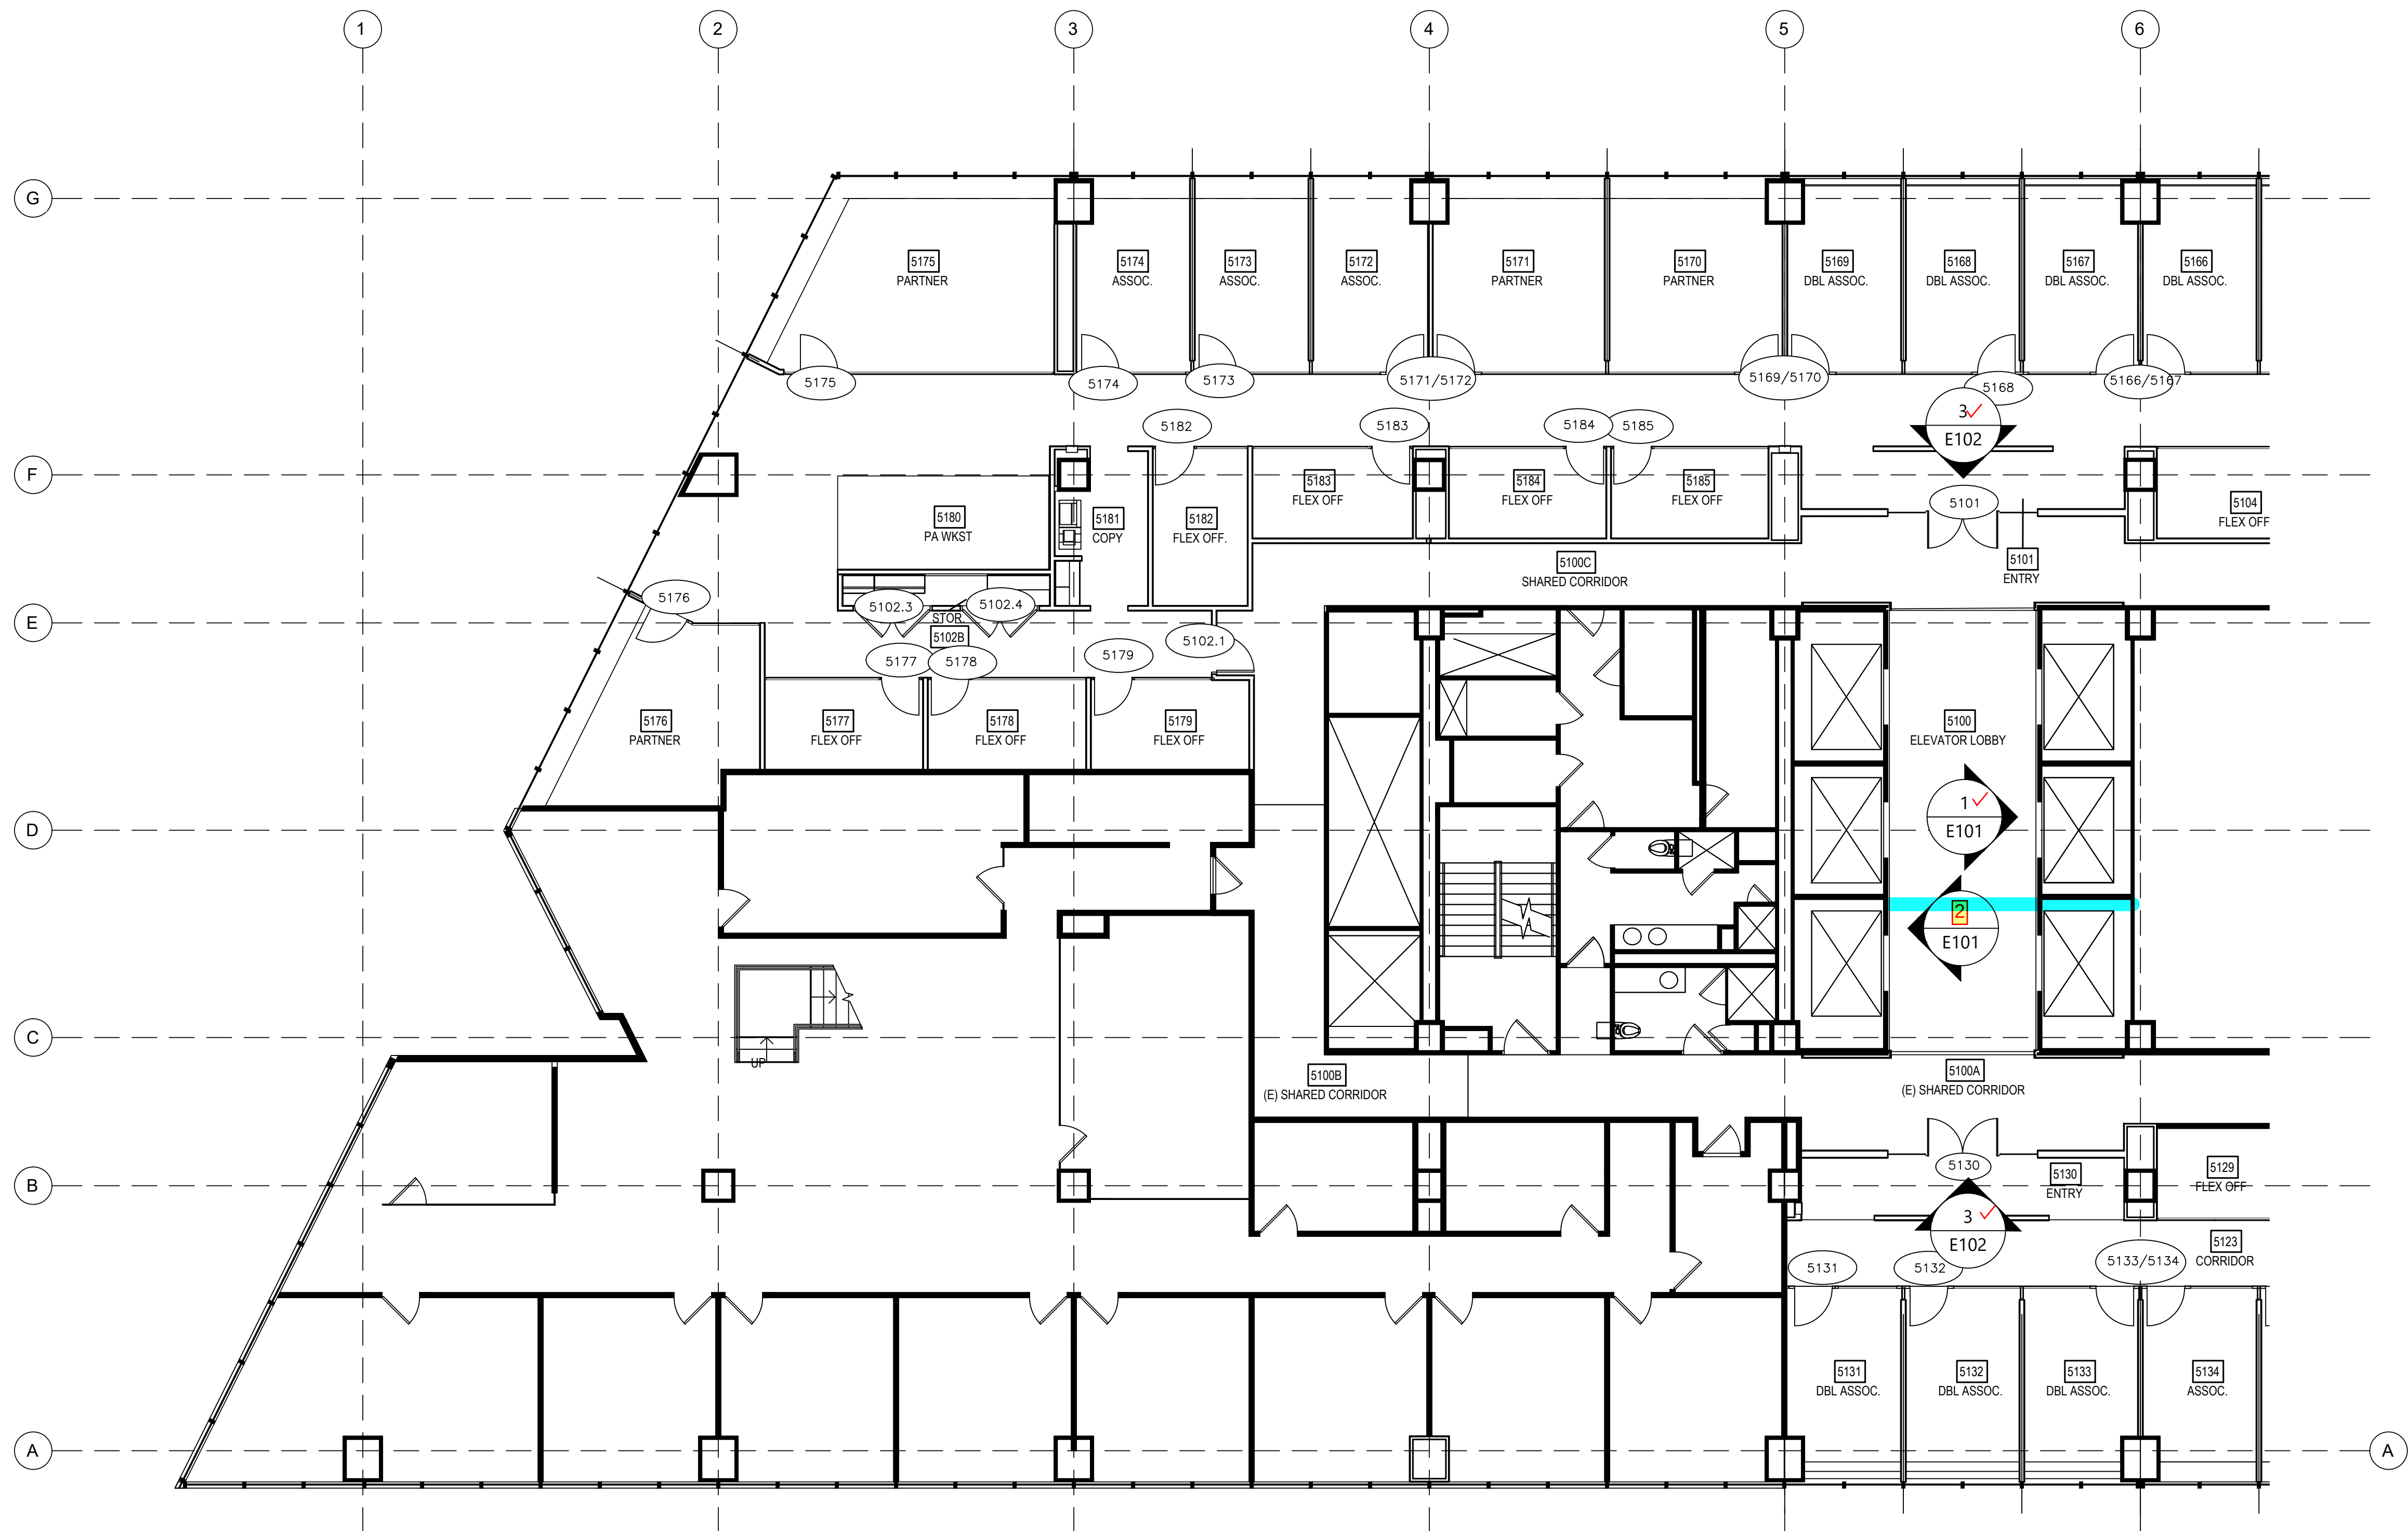

✓
A LEVEL 51— FINISH PLAN— PART A ✓
ARCH REF: 1/A401A ✓






ALL DIMENSIONS TO BE
VERIFIED IN FIELD BY SGC
PRIOR TO FABRICATION

- ✓ GL1 7/16" ACID ETCH LAMINATED MIRROR
✓ GL2 1/2" CLEAR TEMPERED GLASS



The ADOs are changing
Please show a standard header tube with RTS 88 closers
with a surface mounted Dornia ED250 Slim Line.

MAY I SUGGEST YOU MOVE THESE
H-DETAIL BALLS TO THE RIGHT
SIDELITE SO THEY ARE CLOSER
TO THE DIMS THAT MATCH THEM.

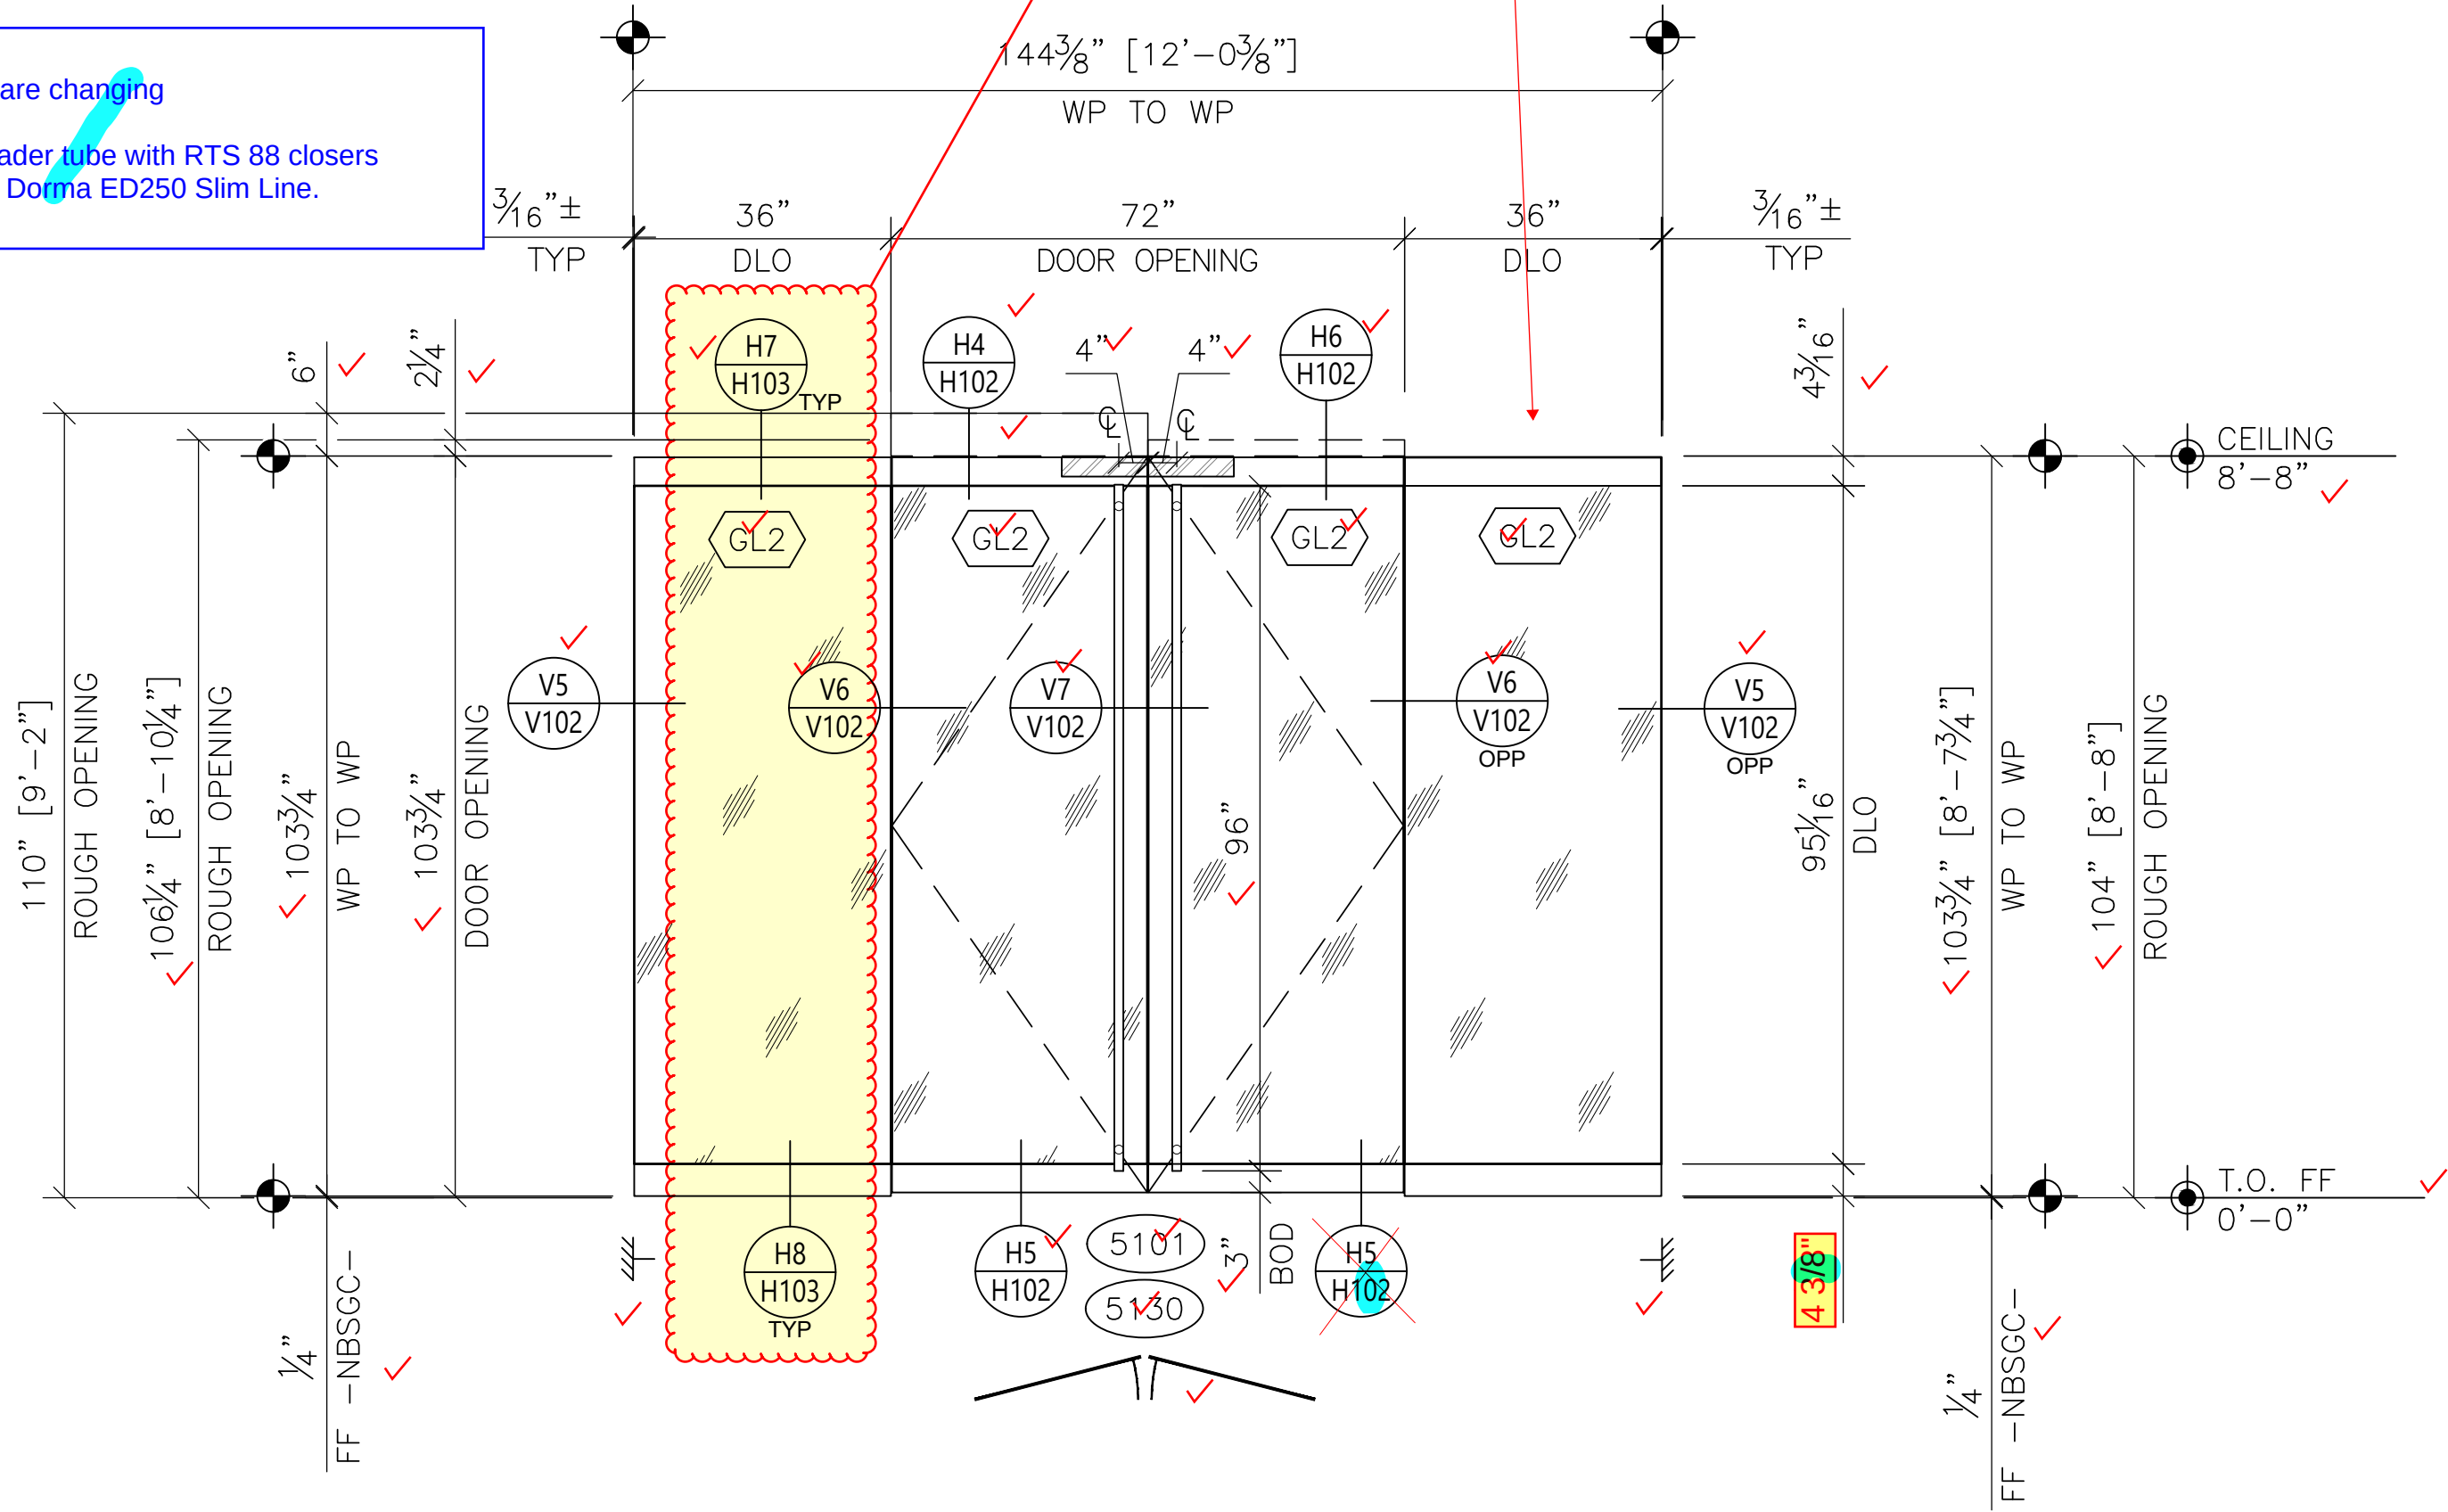

3 ELEVATION—ELEVATOR LOBBY—NORTH & SOUTH
QUANTITY: 2
ARCH REF: 3/A803


REV	DATE	BY	DESCRIPTION
PROJECT		KIRKLAND & ELLIS	
ARCHITECT		HO&K	
GENERAL CONTRACTOR		STRUCTURE TONE, INC	
PROJ NO		8901	
DATE		WORKING	
DRAWN		SM	
CHECKED		SB/MO	
FILE NAME		8109 e 1	
SCALE		1/2"=1'-0"	
SHEET NUMBER		E102	

MICK, IS IT INTENTIONAL THAT THE DETAILS DO NOT MATCH THE ARCHS?


Yes, this is us controlling the narrative to a degree.

DETAIL DOES NOT MATCH ELEVATION

MICK, NEUTRAL CURE OR MIRROR MASTIC?

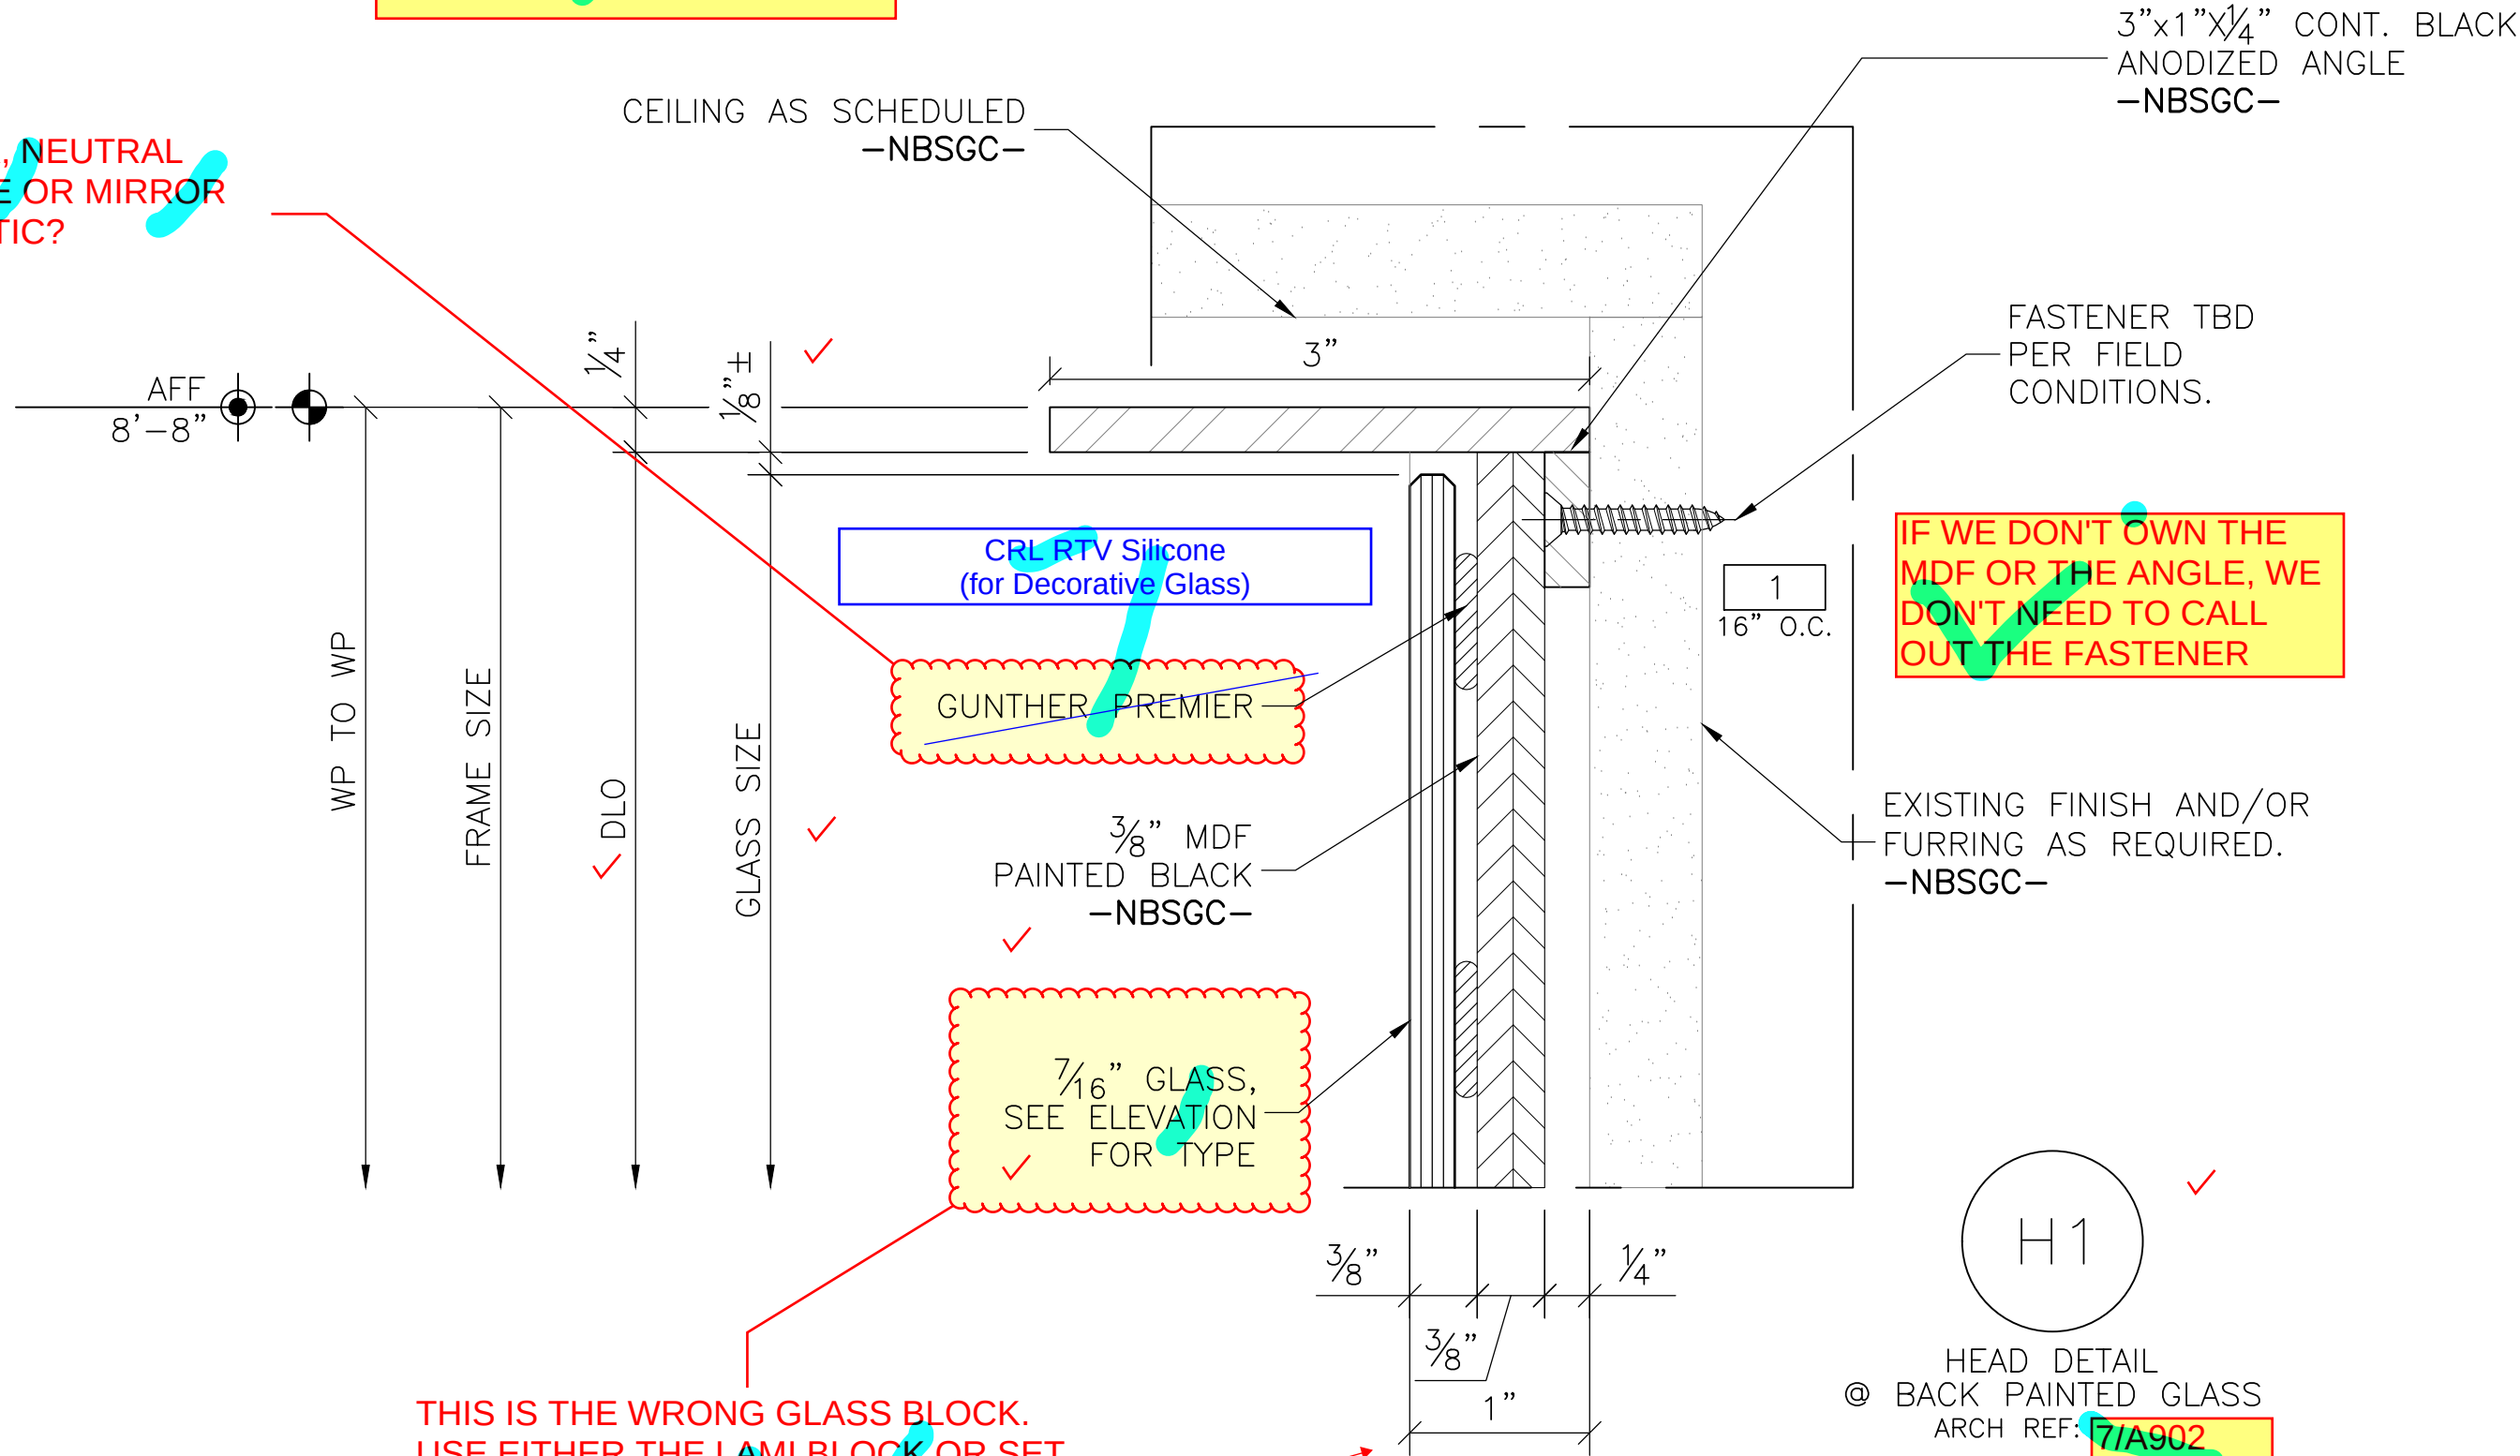

PROJECT	KIRKLAND & ELLIS
ARCHITECT	HO&K
GENERAL CONTRACTOR	STRUTCHER TONE INC.

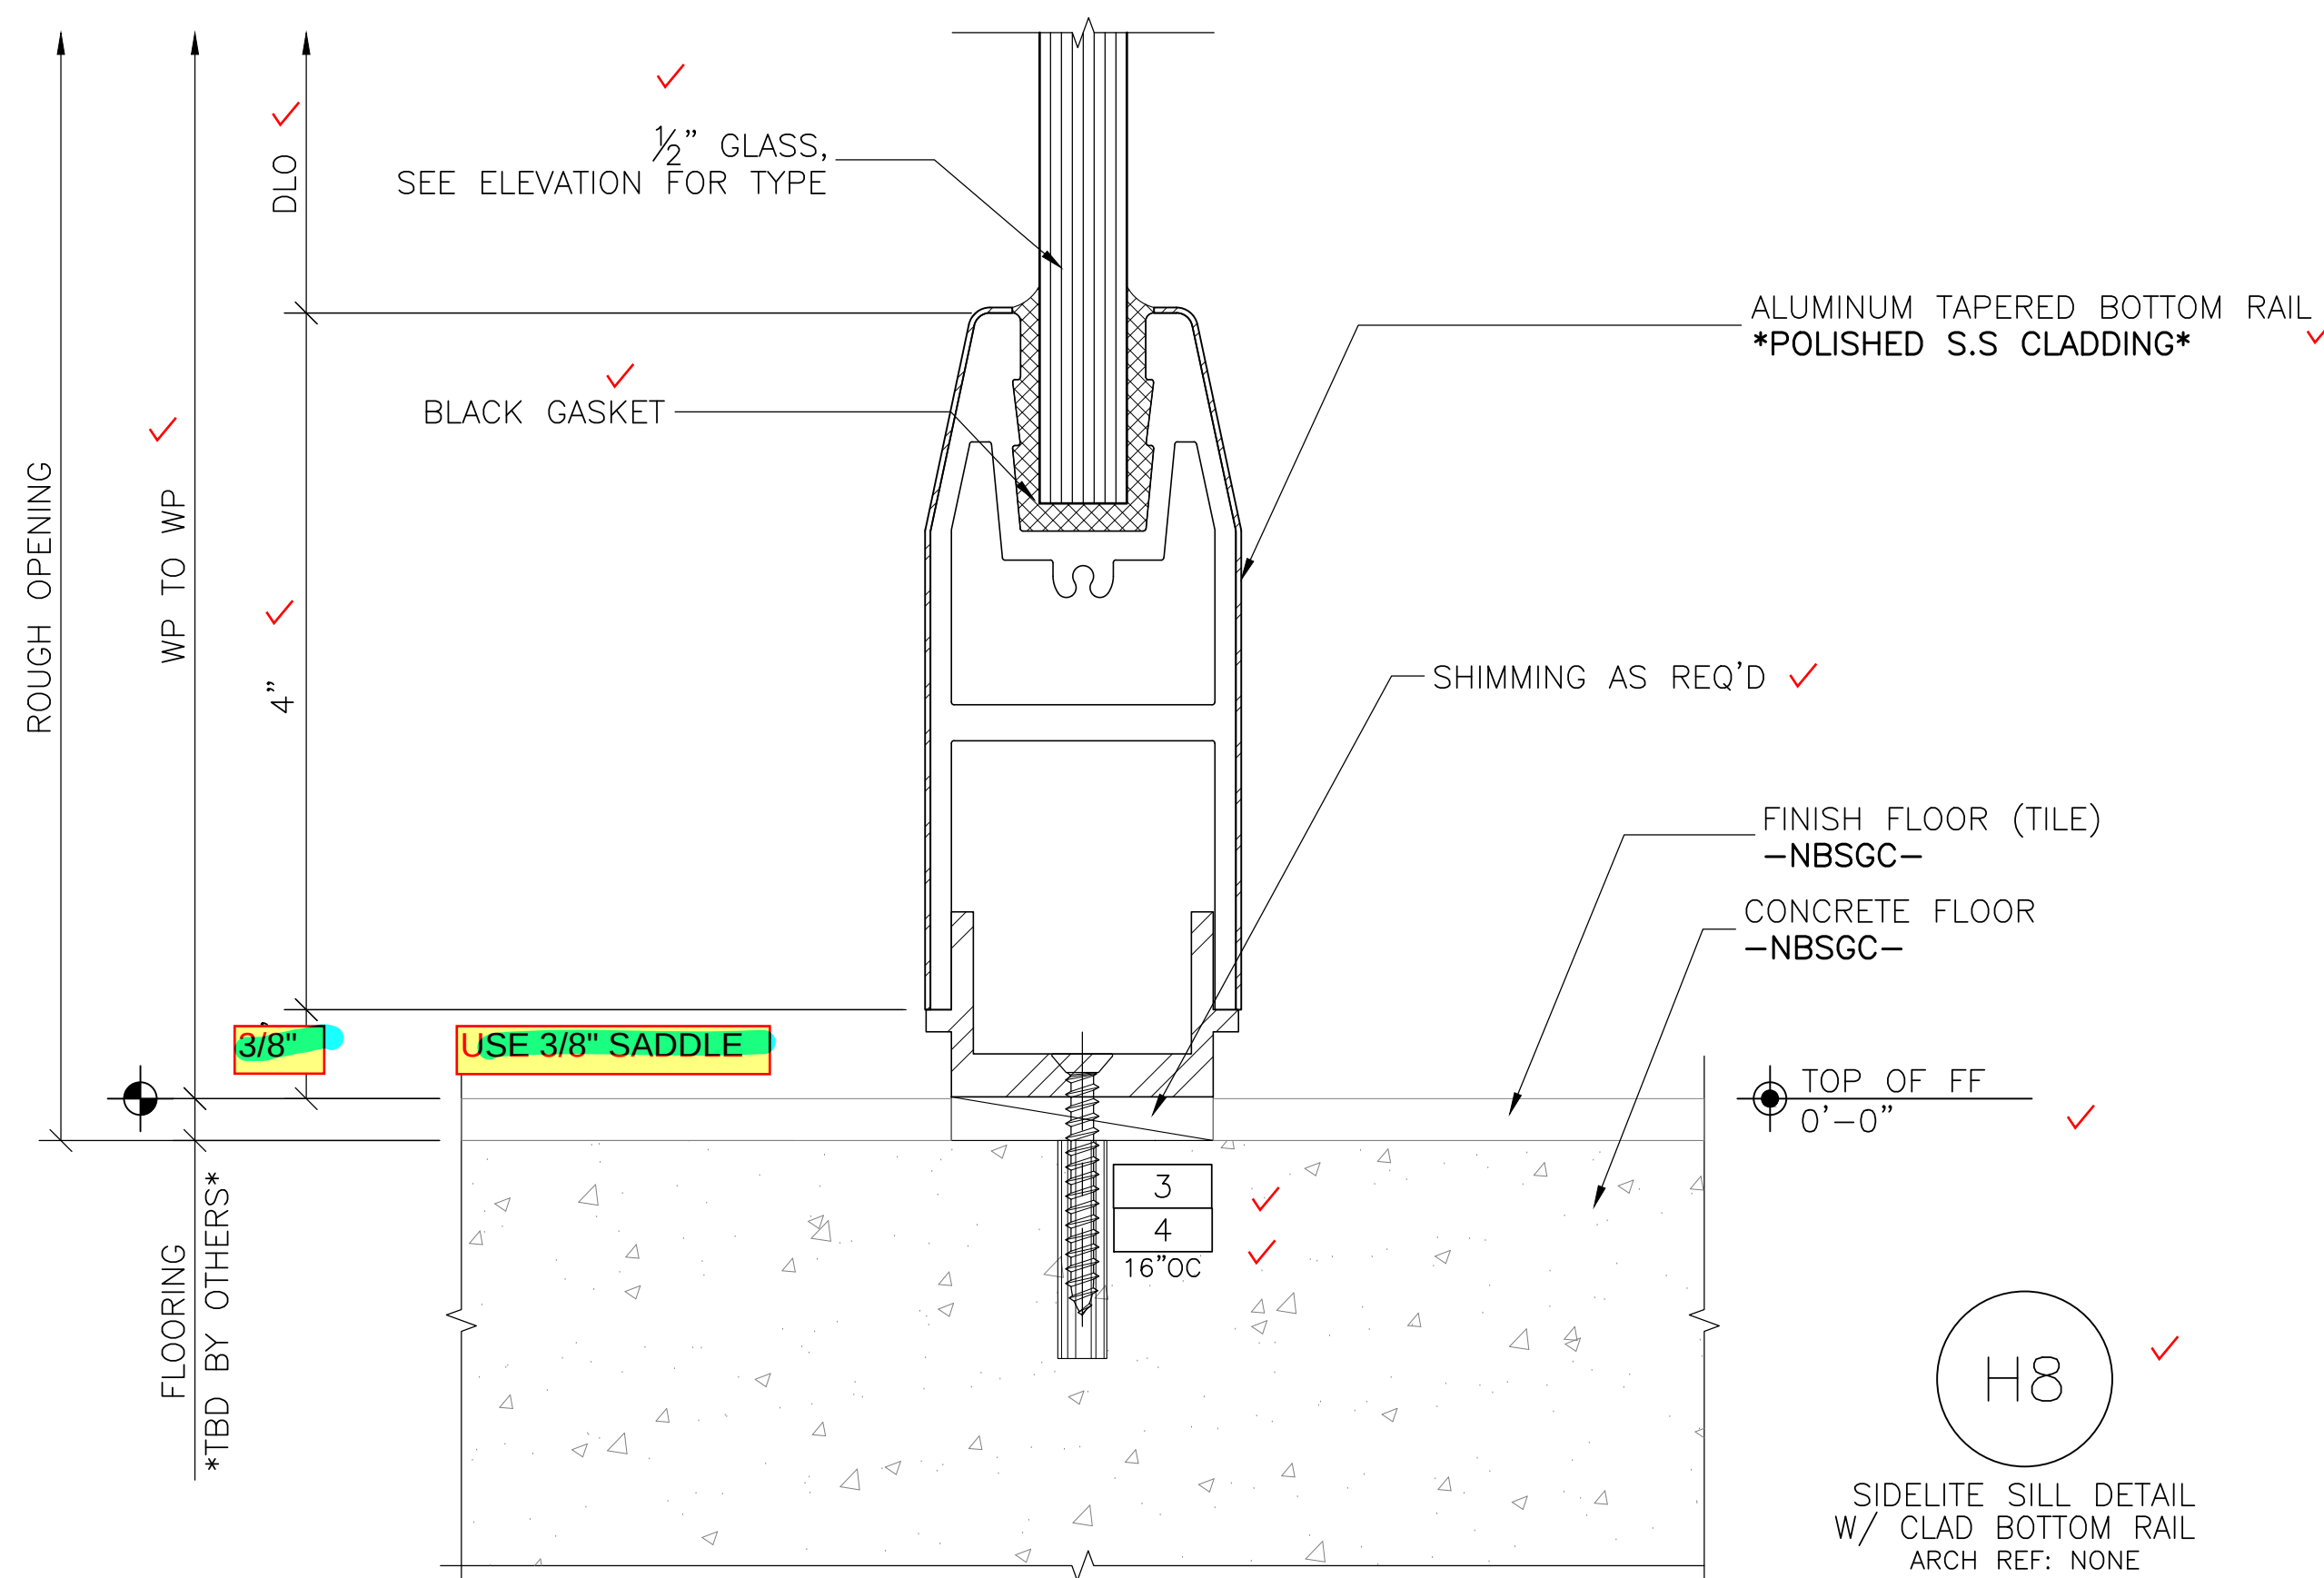


MICK, IS IT INTENTIONAL THAT THE DETAILS DO NOT MATCH THE ARCHS?

SEE NOTES FROM H-DETAILS


ARCHITECT/GC NOTE:

AT BACKPAINTED GLASS LOCATIONS ADHERED TO MDF, THE MDF SHOULD BE PRIME PAINTED ONLY IN A COLOR (LIGHT OR DARK) BASED ON THE BACKPAINTED COLOR. THE PERIMETER WALLS SHOULD BE PAINTED THE FINISH WALL COLOR TO AVOID READ THRU OF THE PRIMER.

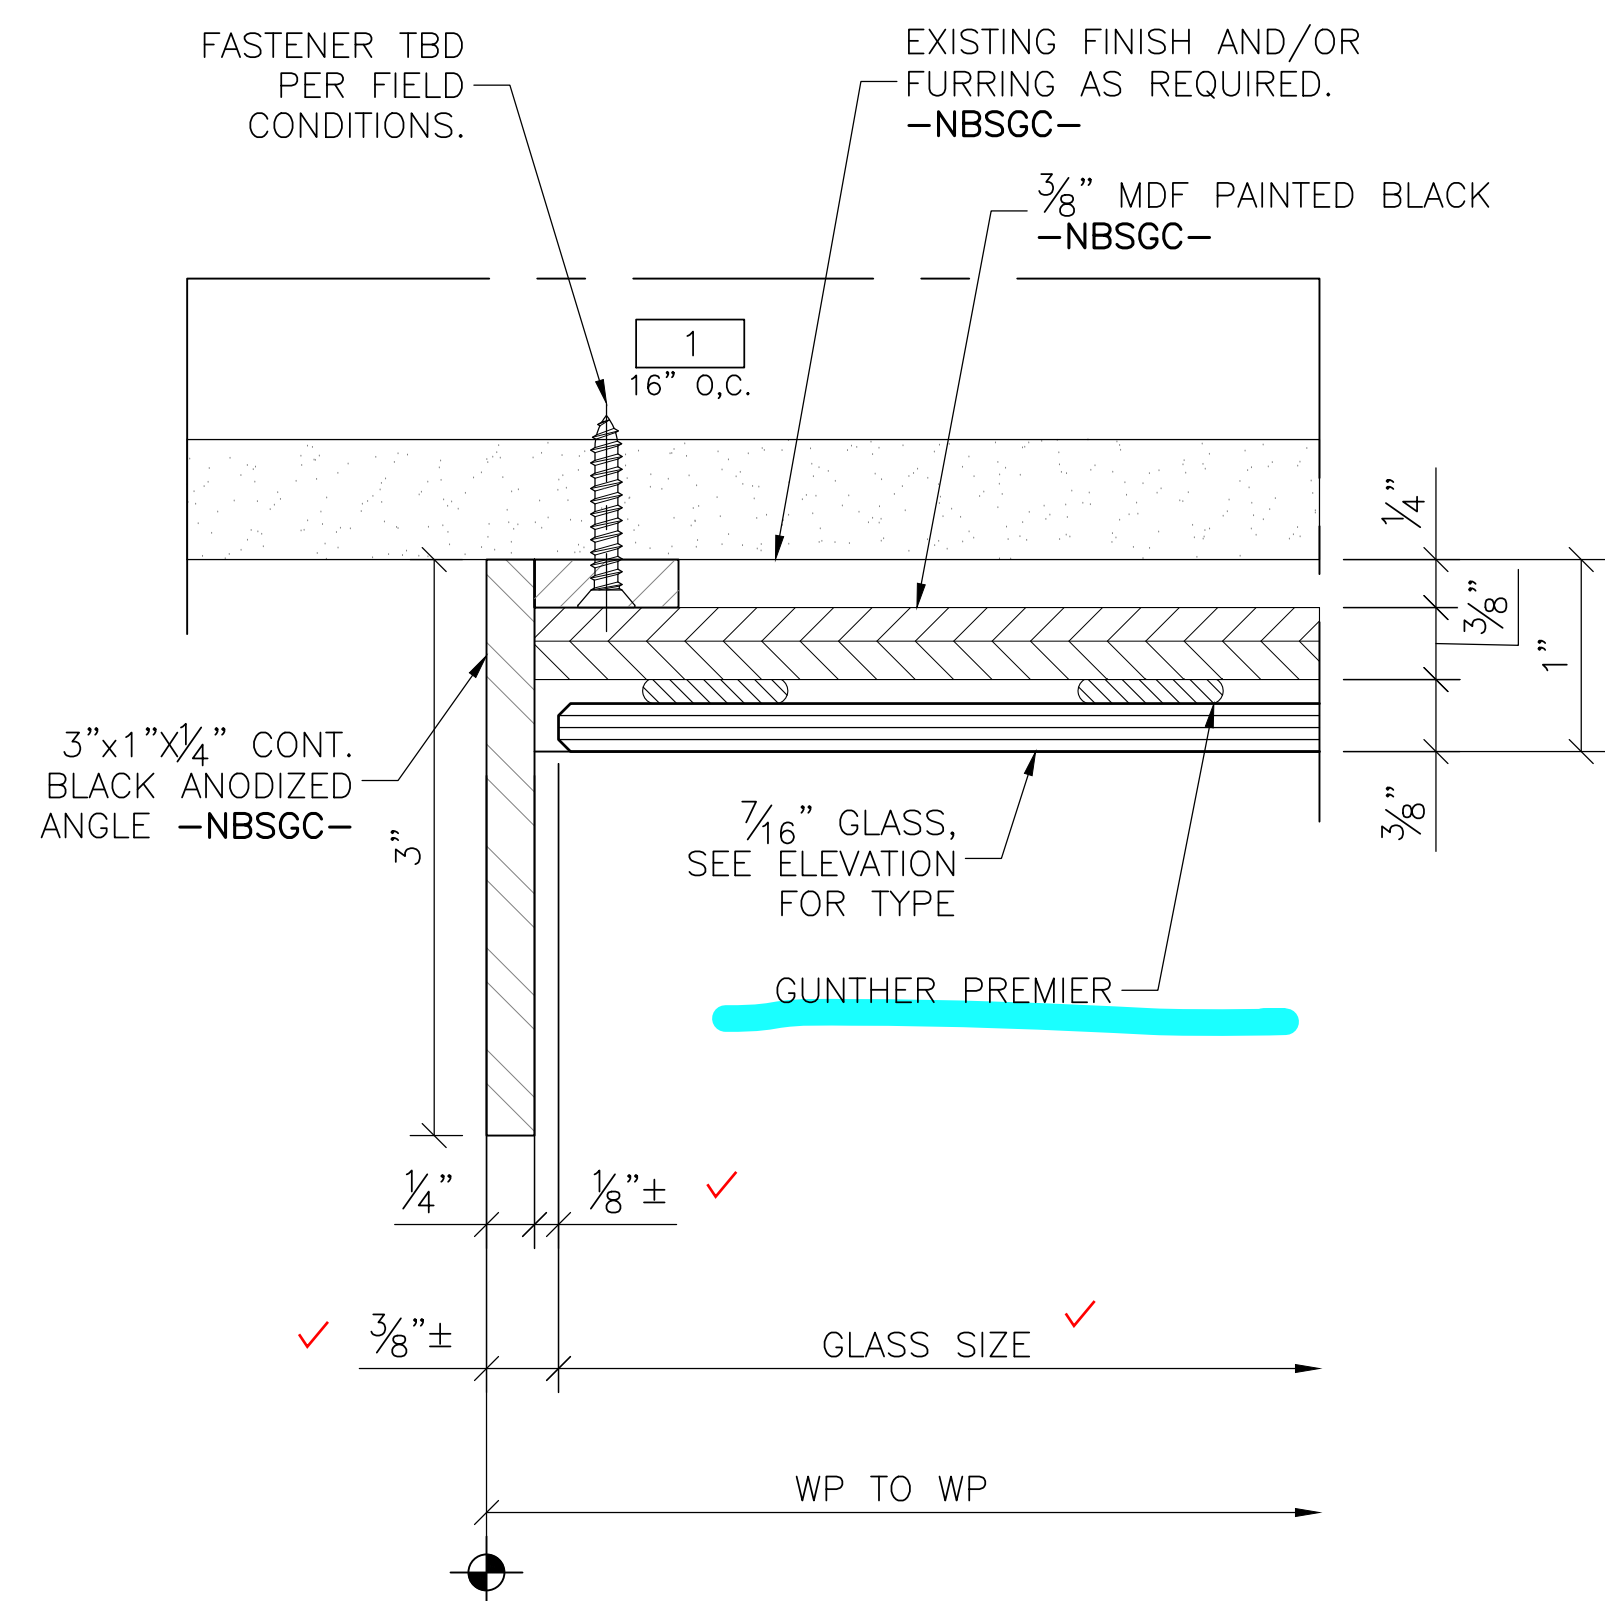


V1
OPEN JAMB
© BACK PAINTED GLASS
ARCH REF: NONE


THIS IS THE WRONG GLASS BLOCK.
USE EITHER THE LAMI BLOCK OR SET
FOR 3/8" NOT 1/4". TYP ALL RELATED
DETAILS. THIS WILL CHANGE YOUR
DEPTH OF CONSTRUCTIONS.

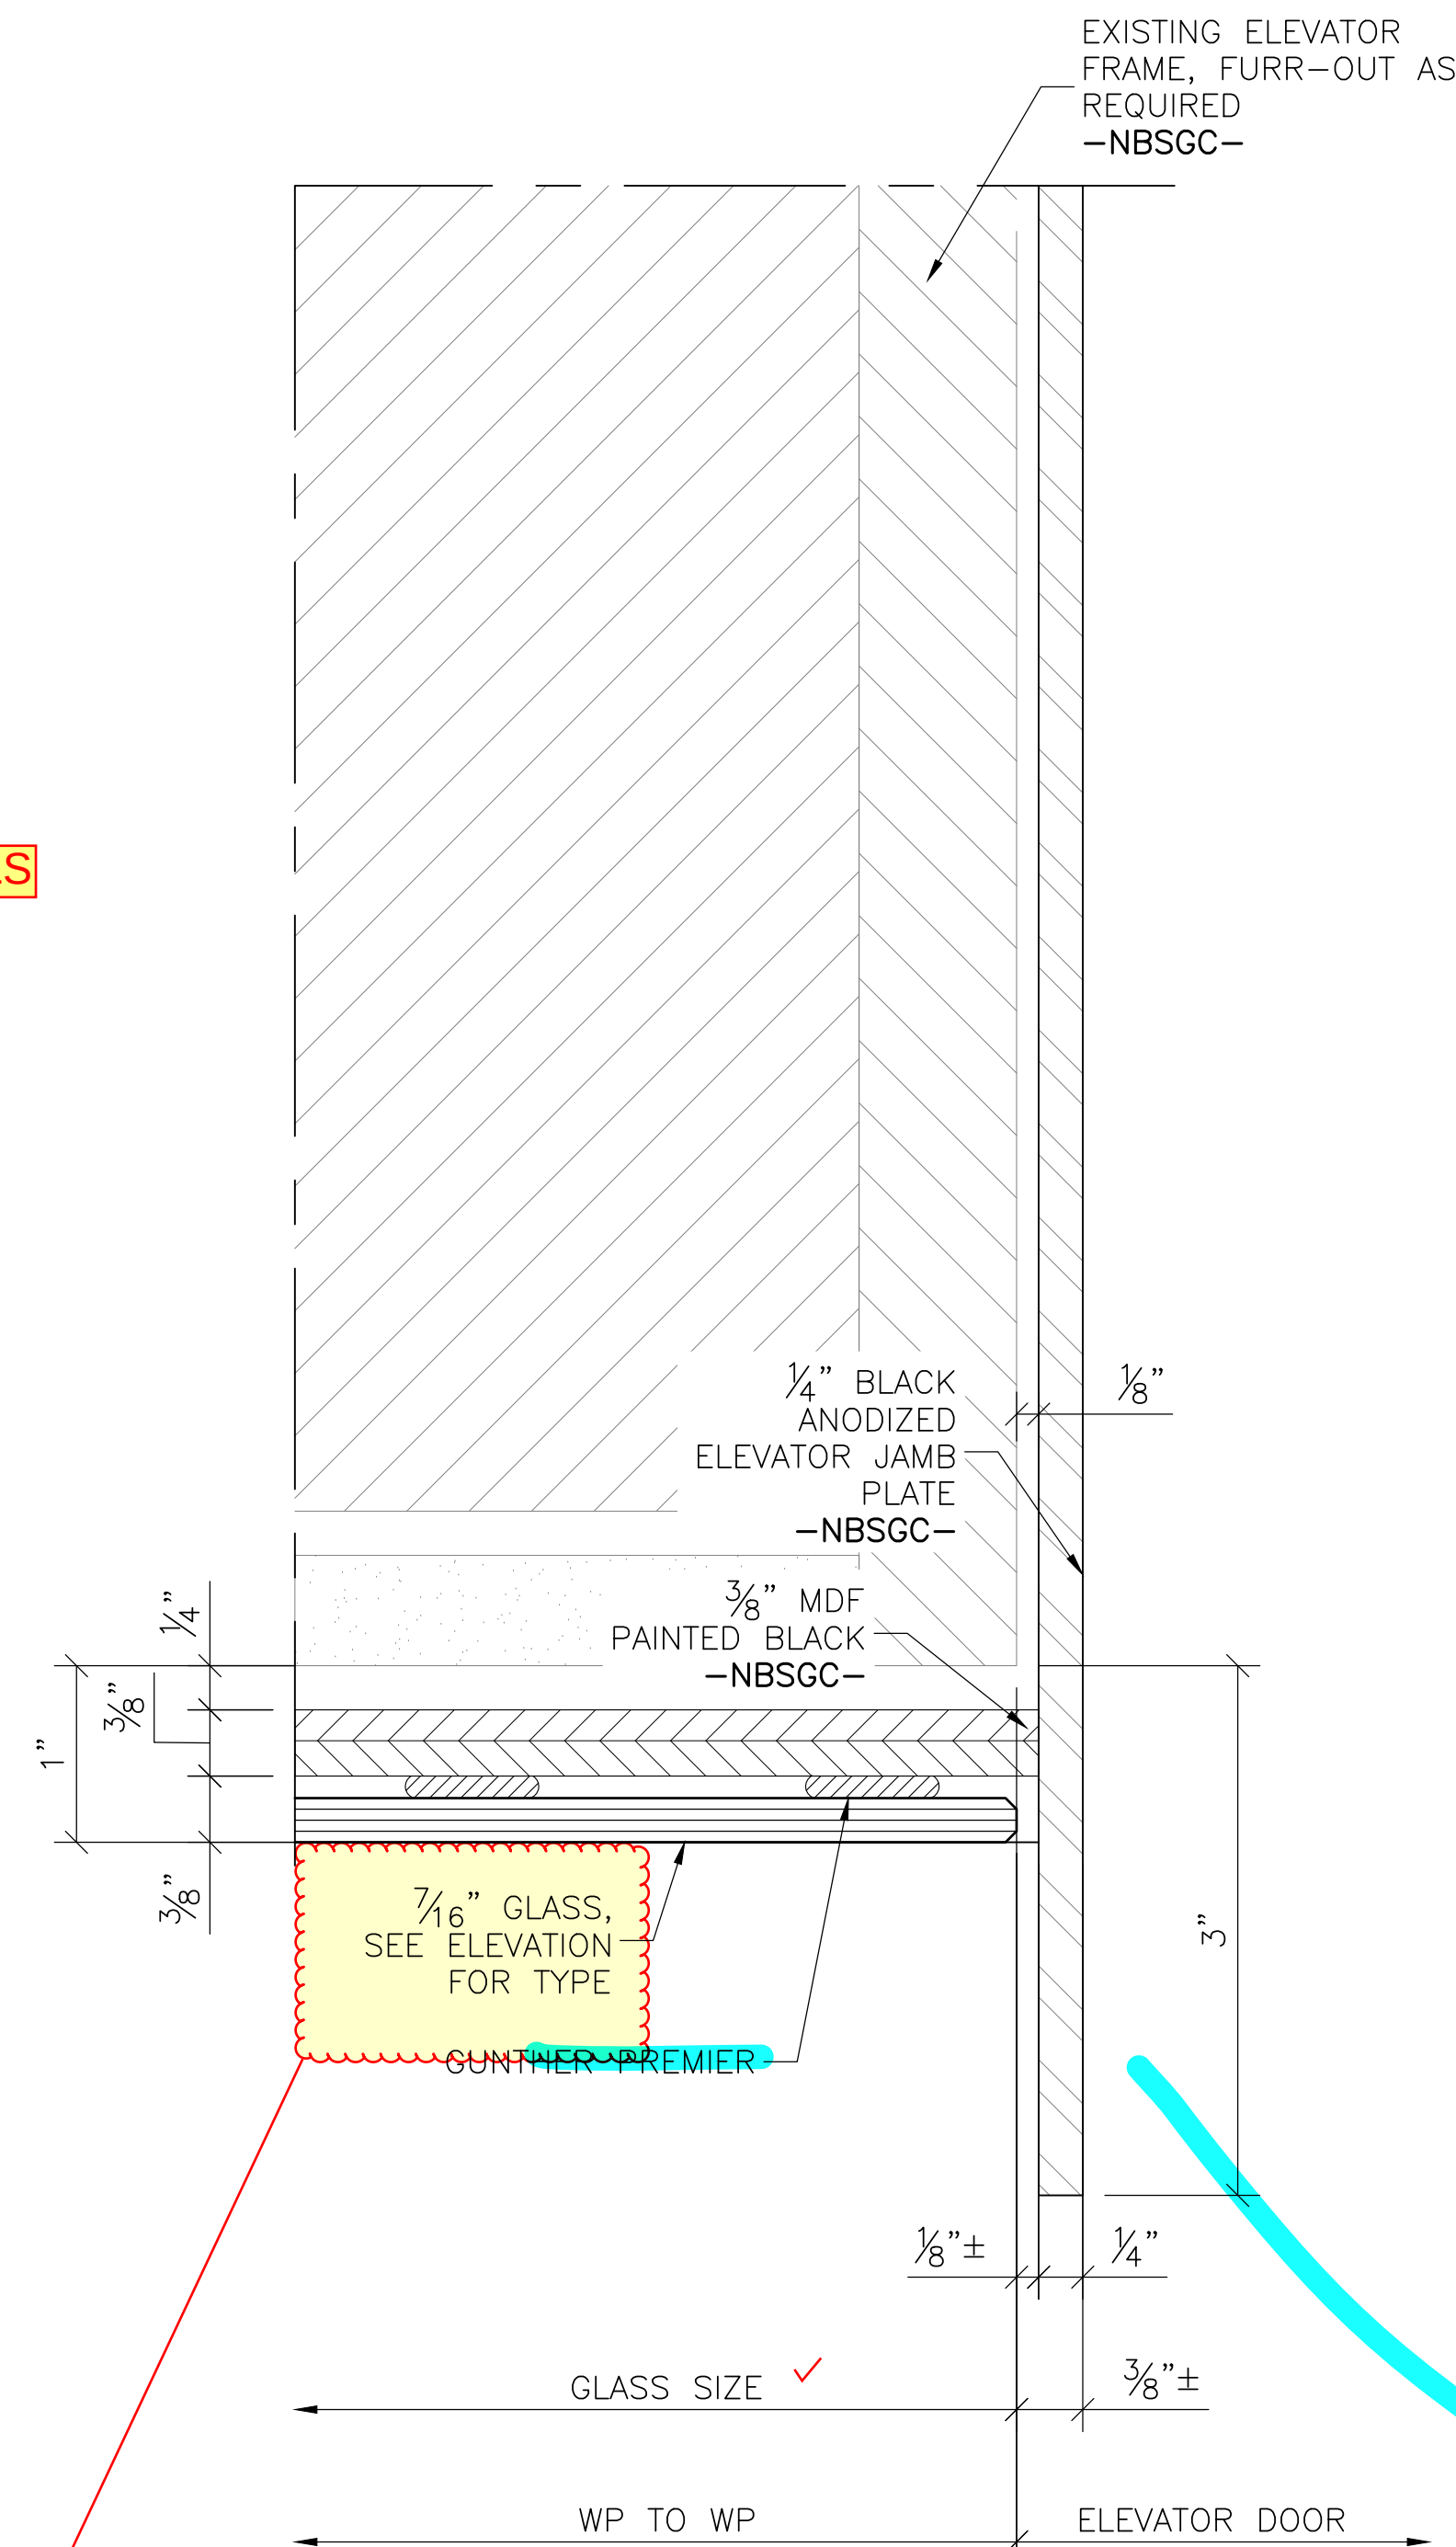

V2
ELEVATOR JAMB
© BACK PAINTED GLASS
ARCH REF: NONE

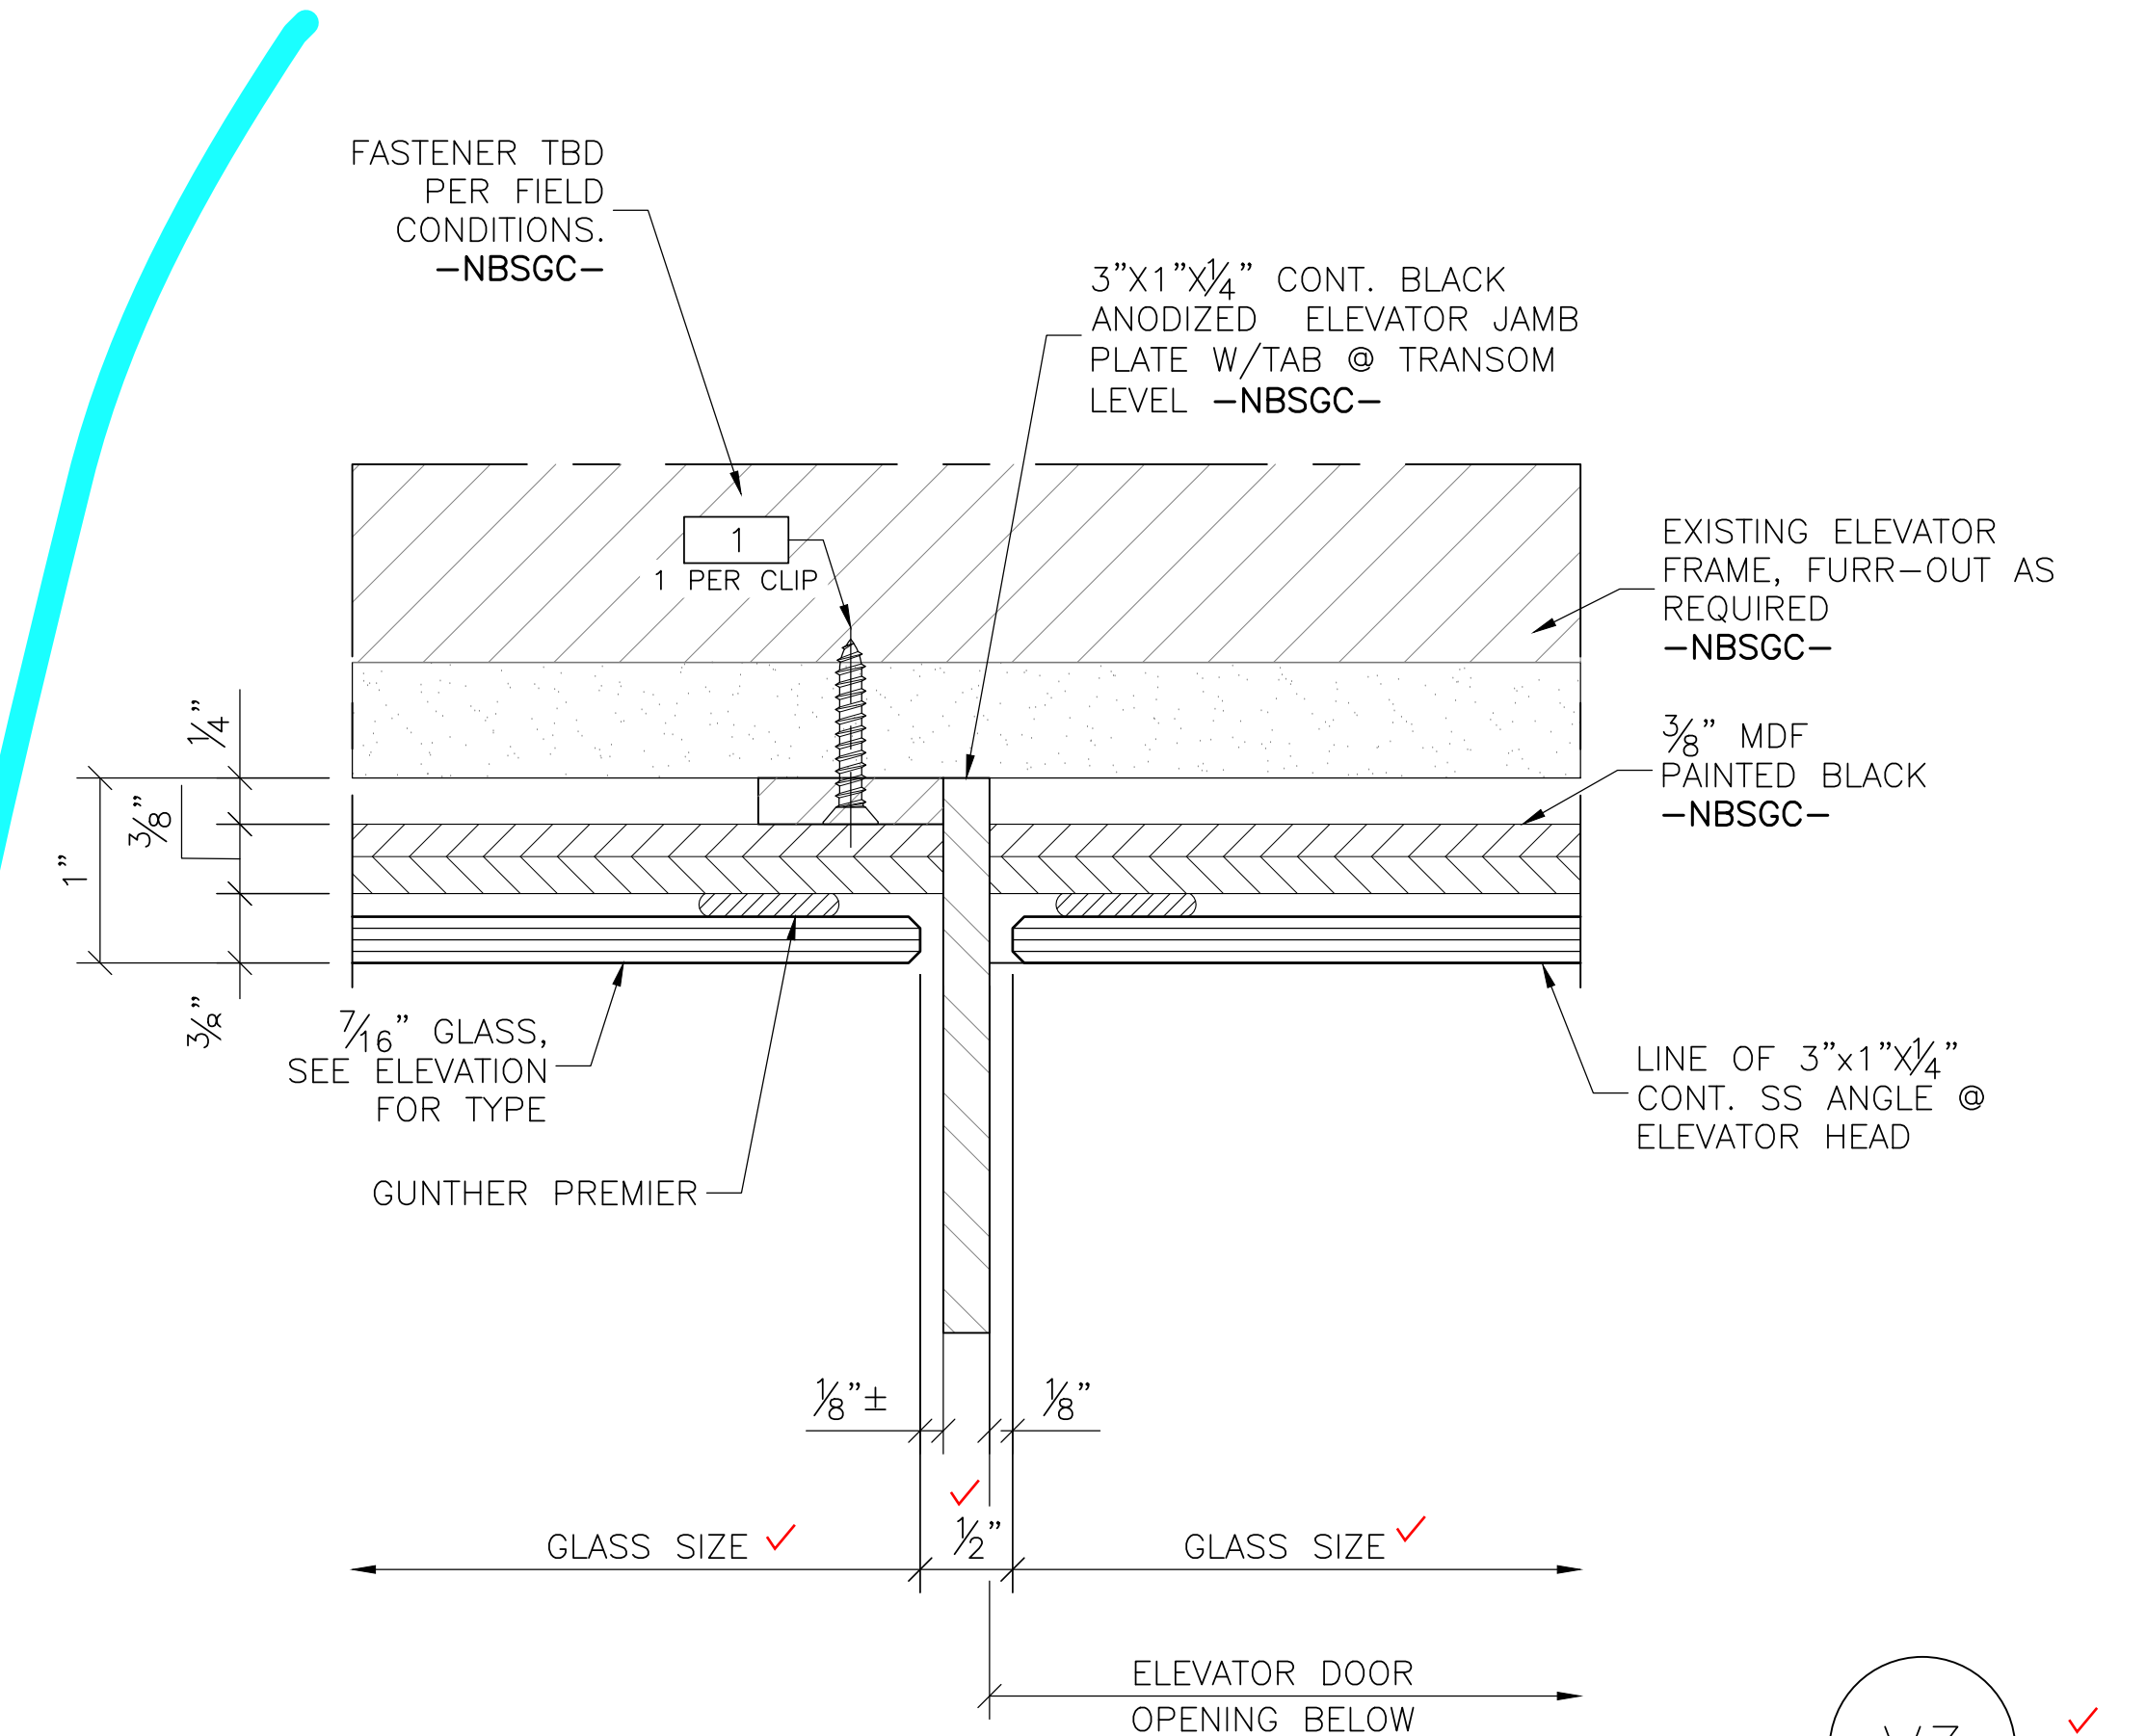

V3
ELEVATOR TRANSOM
© BACK PAINTED GLASS
ARCH REF: NONE

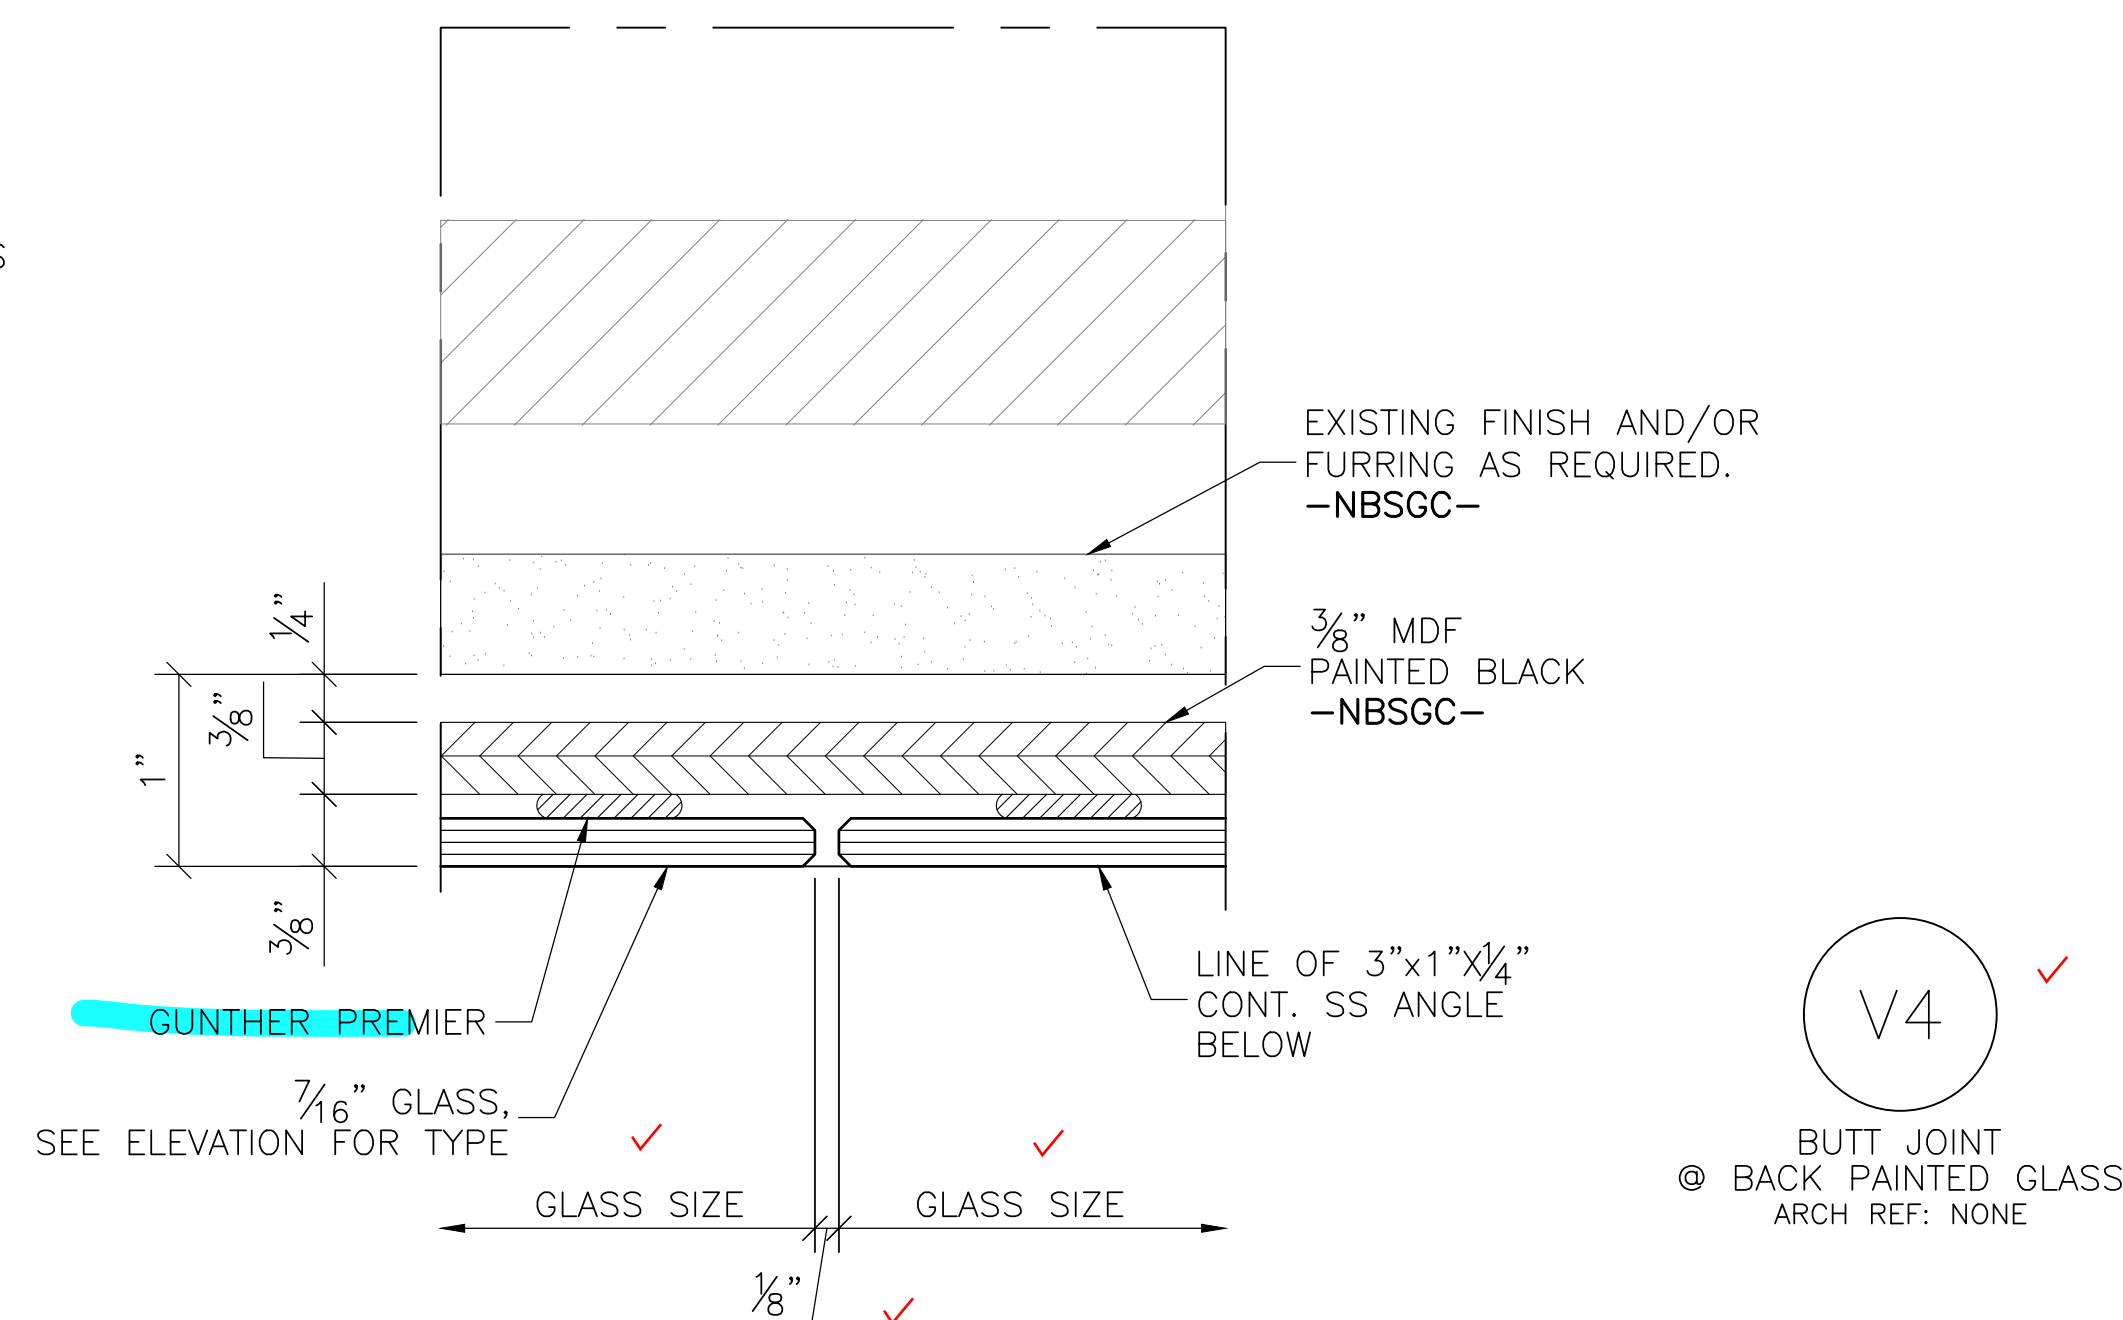

V4
BUTT JOINT
© BACK PAINTED GLASS
ARCH REF: NONE

PROJECT	DESCRIPTION	BY	DATE	REV
KIRKLAND & ELLIS				
ARCHITECT				
HO&K				
GENERAL CONTRACTOR				
STRUCTURE TONE, INC				
PROJ NO	8901			
DATE	WORKING			
DRAWN	SM			
CHECKED	SB/MO			
FILE NAME	8109 v 1			
SCALE	FULL SCALE			
SHEET NUMBER	V101			

REV	DATE	BY	DESCRIPTION

PROJECT	KIRKLAND & ELLIS
ARCHITECT	HO&K
GENERAL CONTRACTOR	STRUCTURE TONE, INC

PROJ NO	8901
DATE	WORKING
DRAWN	SM
CHECKED	SB/MO
FILE NAME	8109 v 1
SCALE	FULL SCALE

SHEET NUMBER	V102
--------------	------

